

STATE OF KANSAS  
STATE CORPORATION COMMISSION


15-147-00418-00-00

Form CP-4

WELL PLUGGING RECORD

Give All Information Completely  
Make Required Affidavit  
Mail or Deliver Report to:  
Conservation Division  
State Corporation Commission  
212 No. Market  
Wichita, Kansas

NORTH

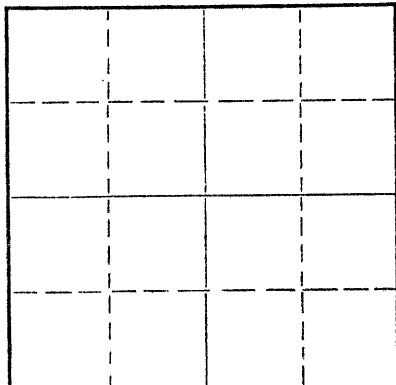

Locate well correctly on above  
Section Plat

Phillips County, Sec. 30 Twp. 1 Rge. 18 (E) (W) x  
Location as "NE/CNW%SW%" or footage from lines SE SE NW  
Lease Owner Sierra Petroleum Co.  
Lease Name Schlutz Well No. #3  
Office Address Box 232, Russell, Kansas  
Character of Well (completed as Oil, Gas or Dry Hole) \_\_\_\_\_  
Date well completed \_\_\_\_\_ 19\_\_\_\_  
Application for plugging filed 8-18-66 19\_\_\_\_  
Application for plugging approved \_\_\_\_\_ 19\_\_\_\_  
Plugging commenced 9-6-66 19\_\_\_\_  
Plugging completed 9-14-66 19\_\_\_\_  
Reason for abandonment of well or producing formation \_\_\_\_\_

If a producing well is abandoned, date of last production \_\_\_\_\_ 19\_\_\_\_  
Was permission obtained from the Conservation Division or its agents before plugging was commenced? \_\_\_\_\_

Name of Conservation Agent who supervised plugging of this well Leo Massey  
Producing formation \_\_\_\_\_ Depth to top \_\_\_\_\_ Bottom \_\_\_\_\_ Total Depth of Well 3610' Feet  
Show depth and thickness of all water, oil and gas formations.

OIL, GAS OR WATER RECORDS

CASING RECORD

FORMATION	CONTENT	FROM	TO	SIZE	PUT IN	PULLED OUT

Describe in detail the manner in which the well was plugged, indicating where the mud fluid was placed and the method or methods used in introducing it into the hole. If cement or other plugs were used, state the character of same and depth placed, from \_\_\_\_\_ feet to \_\_\_\_\_ feet for each plug set.

Made bottom hole plug back with sand to 3375', mixed and ran 3 sacks cement thru dump bailer.  
Squeezed hole with 20 sacks gel and 75 sacks cement.

(If additional description is necessary, use BACK of this sheet)

Name of Plugging Contractor Southwest Casing Pulling Co., Inc.  
Address Box 364, Great Bend, Kansas

STATE OF Kansas, COUNTY OF Barton, ss.  
Southwest Casing Pulling Co., Inc. (employee of owner) or (owner or operator) of the above-described well, being first duly sworn on oath, says: That I have knowledge of the facts, statements, and matters herein contained and the log of the above-described well as filed and that the same are true and correct. So help me God.

(Signature) W. C. Spencer Sec.  
Box 364, Great Bend, Kansas  
(Address)

SUBSCRIBED AND SWORN to before me this 16 day of September f, 1966

My commission expires 24 October 1968

Sidney D. Hill  
Notary Public.

15-147-00418-00-00


WELL LOG BUREAU—KANSAS GEOLOGICAL SOCIETY  
508 East Murdock, Wichita, Kansas

Company- FELDT-MAYTAG & CO.  
Farm- Schluntz No. 3

SEC. 30 T. 1 R. 18W  
SE SE NW

Total Depth. 3610'  
Comm. 5-15-59 Comp. 5-25-59  
Shot or Treated.  
Contractor. Lewis Drlg.  
Issued. 9-26-59

County Phillips  
KANSAS

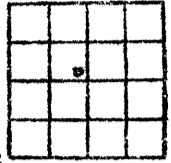

Elevation. 2166' KB

Production. 16 BOPD

CASING:

8 5/8" 212'  
4 1/2" 3610'

Figures indicate Bottom of Formations.

surface	212
shale	1270
shale & shells	1720
shale	1760
Anhydrite	1785
lime & shale	2660
shale & lime streaks	2715
lime	2830
lime & shale	3115
lime	3610
Total Depth	

TOPS:

Heebner	3317
Toronto	3347
Kansas City	3363
Base Kansas City (scout)	3584

RECEIVED  
STATE CORPORATION COMMISSION

SEP 20 1966

CONSERVATION DIVISION  
Wichita, Kansas