

15-147-19055-00-00


STATE OF KANSAS
STATE CORPORATION COMMISSION

Form CP-4

WELL PLUGGING RECORD

Give All Information Completely
Make Required Affidavit
Mail or Deliver Report to:
Conservation Division
State Corporation Commission
212 No. Market
Wichita, Kansas

NORTH

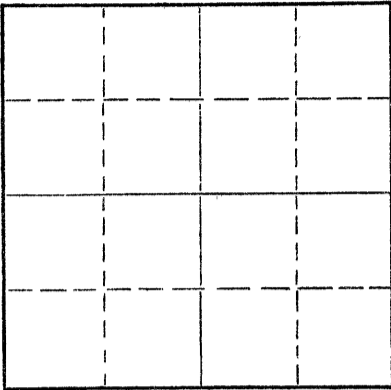

Locate well correctly on above
Section Plat

Phillips County, Sec. 30 Twp. 1 Rge. 18 (E) (W) x
Location as "NE/CNW/SW" or footage from lines SW NE

Lease Owner Sierra Petroleum Co.

Lease Name Schluntz Well No. W-#1

Office Address Box 232, Russell, Kansas

Character of Well (completed as Oil, Gas or Dry Hole)

Date well completed 19

Application for plugging filed 8-22-66 19

Application for plugging approved 19

Plugging commenced 9-15-66 19

Plugging completed 9-15-66 19

Reason for abandonment of well or producing formation

If a producing well is abandoned, date of last production 19

Was permission obtained from the Conservation Division or its agents before plugging was commenced?

Name of Conservation Agent who supervised plugging of this well Leo Massey

Producing formation Depth to top Bottom Total Depth of Well 1548' Feet

Show depth and thickness of all water, oil and gas formations.

OIL, GAS OR WATER RECORDS

CASING RECORD

FORMATION	CONTENT	FROM	TO	SIZE	PUT IN	PULLED OUT

Describe in detail the manner in which the well was plugged, indicating where the mud fluid was placed and the method or methods used in introducing it into the hole. If cement or other plugs were used, state the character of same and depth placed, from feet to feet for each plug set.

Made bottom hole plug back with sand to 760', mixed and ran 5 sacks cement thru dump bailer. Mudded hole to 300', set 20' rock bridge. Mixed and ran 35 sacks cement thru dump bailer from 280' to base of cellar.

RECEIVED
STATE CORPORATION COMMISSION
SEP 19 1966
CONSERVATION DIVISION
WICHITA, KANSAS

(If additional description is necessary, use BACK of this sheet)

Name of Plugging Contractor Southwest Casing Pulling Co., Inc.

Address Box 364, Great Bend, Kansas

STATE OF Kansas, COUNTY OF Barton, ss.
Southwest Casing Pulling Co., Inc. (employee of owner) or (owner or operator) of the above-described well, being first duly sworn on oath, says: That I have knowledge of the facts, statements, and matters herein contained and the log of the above-described well as filed and that the same are true and correct. So help me God.

(Signature) W. C. Spencer, Jr.

Box 364, Great Bend, Kansas (Address)

SUBSCRIBED AND SWORN TO before me this 16 day of September, 19 66

Sidney D. Miller
Notary Public.

My commission expires 24 October 1968

15-147-19055-00-00



SIERRA PETROLEUM CO., INC.

Box 232
XXXXXXXXXXXXXXXXXXXXXXXXXXXX . XXXXXXXXXXXXXXXXXXXXXXXXXXXXXXX
Russell, Kansas 67665

Ph. 483-3136 A.C. 913
XXXXXXXXXXXXXXXXXXXXXXXXXXXX

October 29, 1966

RECEIVED
STATE CORPORATION COMMISSION

OCT 31 1966

CONSERVATION DIVISION
Wichita, Kansas

State Corporation Commission
Conservation Division
500 Insurance Building
212 North Market
Wichita, Kansas 67665

Re: Schluntz W-1 ^{18w}
SW NE - Sec. 30-1S-19W
Phillips Co., Kansas


Dear Sirs

With reference to your second notice of Oct. 26th, requesting drillers log on subject well, please be advised that our well files do not contain a drillers log for this well.

These properties were purchased from Feldt-Maytag and this information was not included with well files we received.

We have previously submitted to your office all information which we have on this well.

Very truly yours

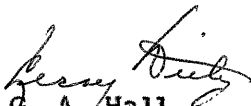(for) 
G. A. Hall
Production Superintendent

GAH:ld

Log Not Available