

Give All Information Completely
Make Required Affidavit
Mail or Deliver Report to:
Conservation Division
State Corporation Commission
212 North Market, Insurance Bldg.
Wichita, Kansas

Norton County. Sec. 20 Twp. 1S Rge. 22W (E) (W)

Location as "NE/CNW/SW" or footage from lines. C SE NE/4

Lease Owner Sinclair Oil & Gas Company

Lease Name Ralph Rorabaugh, Jr. Well No. 1

Office Address Box 521, Tulsa, Oklahoma

Character of Well (completed as Oil, Gas or Dry Hole) Dry Hole

Date well completed 8-22-61 19

Application for plugging filed 8-23-61 19

Application for plugging approved 8-28-61 19


Plugging commenced 8-22-61 19

Plugging completed 8-22-61 19

Reason for abandonment of well or producing formation Dry Hole

If a producing well is abandoned, date of last production 19

Was permission obtained from the Conservation Division or its agents before plugging was commenced? Yes

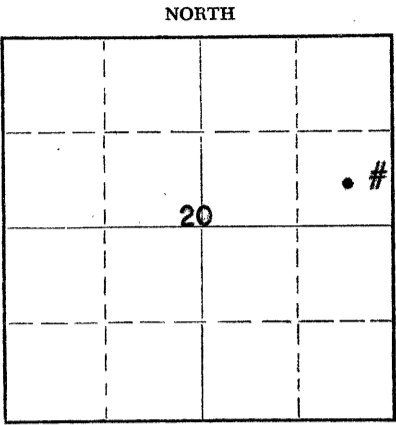

Locate well correctly on above Section Plat

Name of Conservation Agent who supervised plugging of this well Eldon Petty

Producing formation None Depth to top Bottom Total Depth of Well Feet

Show depth and thickness of all water, oil and gas formations.

OIL, GAS OR WATER RECORDS

CASING RECORD

FORMATION	CONTENT	FROM	TO	SIZE	PUT IN	PULLED OUT
<u>None encountered</u>						

Describe in detail the manner in which the well was plugged, indicating where the mud fluid was placed and the method or methods used in introducing it into the hole. If cement or other plugs were used, state the character of same and depth placed, from feet to feet for each plug set.

Mudded hole from TD 3800' to 540', from 540' to 480' with 20 sacks cement, Mudded hole from 480' to 180', from 180' to 120' with 20 sacks cement, from 120' to 40' with drlg. mud and from 40' to surface with 10 sacks cement. Hole plugged as per Mr. Eldon Petty, State Inspector's instructions. Completed plugging and abandoning at 3:30PM 8-22-61.

RECEIVED
STATE CORPORATION COMMISSION

AUG 31 1961

CONSERVATION DIVISION
Wichita, Kansas

Aug 31, 1961

(If additional description is necessary, use BACK of this sheet)

Name of Plugging Contractor National Drilling Company

Address Wichita, Kansas

STATE OF Kansas, COUNTY OF Rice, ss.

P. J. Corey (employee of owner) or (owner or operator) of the above-described well, being first duly sworn on oath, says: That I have knowledge of the facts, statements, and matters herein contained and the log of the above-described well as filed and that the same are true and correct. So help me God.

(Signature) P. J. Corey

Acting District Superintendent

(Address)

SUBSCRIBED AND SWORN TO before me this 20th day of August, 19 61

L. B. Reynolds Notary Public.

My commission expires August 13, 1962

KANSAS GEOLOGICAL SOCIETY
 KANSAS WELL LOG BUREAU - KANSAS WELL SAMPLE BUREAU
 KANSAS GEOLOGICAL SOCIETY BUILDING
 508 EAST MURDOCK - WICHITA, KANSAS

COMPANY *Sinclair Oil & Gas*

SEC. 20 T. 1S R. 22W
 LOG. C SW NE

FARM *Ralph Rorabaugh Jr. NO. 1* 15-137-00181-00-00 ⁵⁰


TOTAL DEPTH 3800'

COUNTY *Norton*
 KANSAS

COMM. 8-14-61

COMP. 8-22-61

SHOT OR TREATED

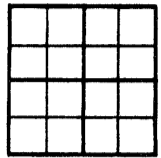

CONTRACTOR *National Drilling Company*

ISSUED

CASING

20	10	
15	8 5/8	333' 336' w/225 sks cement
12	6	
13	5	

ELEVATION 2417

PRODUCTION *D & A*

FIGURES INDICATE BOTTOM OF FORMATIONS

XX	
Clay	40
Clay	123
Post Rock	135
Sand	210
Shale & Iron	570
Shale	1480
Shale	1610
Sand & Shale	1785
Shale & Shell	1990
Anhydrite	2020
Shale & Shells	2295
Shale	2500
Lime	2560
Lime & Shale	2730
Shale & Lime	2855
Lime & Shale	2960
Lime & Shale	3050
Lime	3175
Lime	3340
Lime	3465
Lime	3493
Lime	3605
Lime	3672
Lime	3770
Lime	3800
Total Depth	3800

RECEIVED
 STATE CORPORATION COMMISSION

AUG 31 1961

CONSERVATION DIVISION
 Wichita, Kansas

I hereby certify that this is a true and correct log of the above described well as shown by the drilling reports.

NATIONAL DRILLING COMPANY, INC.

Howard A. Stoskopf

 Howard A. Stoskopf

STATE OF KANSAS)
)
 SEDGWICK COUNTY)

Subscribed and sworn to before me, a Notary Public, in and for said County and State this 25th day of August, 1961.

Dorothy L. Kimball

 Notary Public - Dorothy L. Kimball

My Commission Expires: May 31, 1965.