


STATE-CORPORATION COMMISSION

Give All Information Completely
 Make Required Affidavit
 Mail or Deliver Report to:
 Conservation Division
 State Corporation Commission
 211 No. Broadway
 Wichita, Kansas

15-137-20009-00-00
WELL PLUGGING RECORD

NORTH

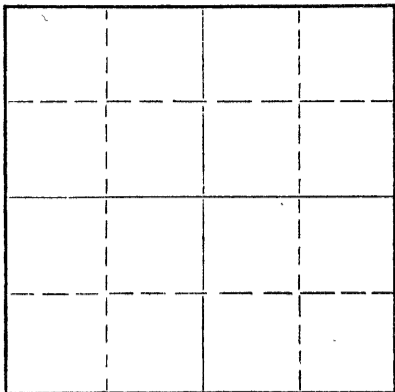

Locate well correctly on above
 Section Plat

Norton County. Sec. 15 Twp. 1S Rge. 24W (E) (W)
 Location as "NE/CNW/SW" or footage from lines C/NW NW
 Lease Owner Raymond Oil Co., Inc. - Murfin Drilling Co.
 Lease Name MC KINLEY Well No. 1
 Office Address 617 Union Center Building - Wichita 2, Kansas
 Character of Well (completed as Oil, Gas or Dry Hole) Dry Hole
 Date well completed 1/5/62 19__
 Application for plugging filed 1/5/62 19__
 Application for plugging approved 1/5/62 19__
 Plugging commenced 1/5/62 19__
 Plugging completed 1/5/62 19__
 Reason for abandonment of well or producing formation Dry Hole

If a producing well is abandoned, date of last production _____ 19__
 Was permission obtained from the Conservation Division or its agents before plugging was commenced? Yes

Name of Conservation Agent who supervised plugging of this well Mr. Eldon Petty - Hays, Kansas
 Producing formation _____ Depth to top _____ Bottom _____ Total Depth of Well 3566' Feet
 Show depth and thickness of all water, oil and gas formations.

OIL, GAS OR WATER RECORDS

CASING RECORD

FORMATION	CONTENT	FROM	TO	SIZE	PUT IN	PULLED OUT
				8 5/8"	183'	None

Describe in detail the manner in which the well was plugged, indicating where the mud fluid was placed and the method or methods used in introducing it into the hole. If cement or other plugs were used, state the character of same and depth placed, from _____ feet to _____ feet for each plug set.

Mud to 550', Set 1st plug with 20 sacks cement through Drill Pipe.
 Set 2nd plug 180' with 15 sacks cement. Bridged Hole and Set
 3rd plug 35' with cement to bottom of cellar.

RECEIVED
 CONSERVATION DIVISION
 WICHITA, KANSAS
 JAN 25 1962

Jan 25, 1962

(If additional description is necessary, use BACK of this sheet)
 Name of Plugging Contractor Murfin Drilling Company
 Address 617 Union Center Building - Wichita 2, Kansas

STATE OF Kansas, COUNTY OF Sedgwick, ss.
Fred Murfin - Partner (~~employee of owner~~) or (~~lessee or operator~~) of the above-described well, being first duly sworn on oath, says: That I have knowledge of the facts, statements, and matters herein contained and the log of the above-described well as filed and that the same are true and correct. So help me God.

(Signature) *Fred Murfin*
617 Union Center Bldg. - Wichita 2, Kansas
 (Address)

SUBSCRIBED AND SWORN TO before me this 23 day of January, 19 62

My commission expires June 14, 1964

Mary Frances Bluma
 Notary Public.



WELL LOG 15-137-00009-00-00

COMPANY **Raymond Oil Co., Inc. - Murfin Drig. Co.**


SEC. 15 T. 18 R. 24W

FARM **MC KINLEY** NO. **One**

LOC. **C/NW NW**

TOTAL DEPTH **3566'**
 COMM. **12/30/61** COMP. **1/5/62**
 SHOT OR TREATED **No**
 CONTRACTOR **Murfin Drilling Company**
 ISSUED

COUNTRY **Norton County**
KANSAS

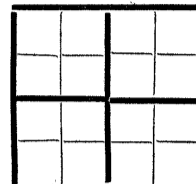

CASING
 20 10
 15 8 5/8" 183' with 135 sacks cement
 12 6
 13 5

ELEVATION **2373' KB**

PRODUCTION **D & A**

FIGURES INDICATE BOTTOM OF FORMATIONS

90' Surface Sand & Clay
 100' Water, Gravel
 925' Shale
 1760' Sand & Shale
 1990' Red Bed & Shale
 2020' Anhydrite
 2100' Red Bed
 2325' Shale & Lime Shells
 2785' Shale-Shells
 3445' Lime & Shale
 3566' Lime
 3566' Rotary Total Depth

ELECTRIC LOG TOPS:

Anhydrite	1895'	+478
Heebner	3258'	-885
Toronto	3289'	-916
Lansing/K.C.	3298'	-925
Base/K.C.	3494'	-1121
Granite Wash	3551'	-1178
Pre-Cambrian	3558'	-1185
Log Total Depth	3566'	-1193

DST #1 3345'-3380' Open 1 hr. Recovered 90' very slightly oil cut mud. IF 50# FF 90# ISIP 1150#/30 min. FSIP 815#/30 min.

DST #2 3412'-3445' Open 1 hr. Recovered 5' drilling mud. IF 35# FF 35# ISIP 370#/30 min. FSIP 50#/30 min.

CORE - NONE

RECEIVED
 STATE COLLEGE
 COMMISSION

JAN 25 1962
 CONSERVATION DIVISION
 Wichita, Kansas
 Jan 25, 1962

State of Kansas }
 County of Sedgwick } ss:

I, Fred Murfin - Partner of the Murfin Drilling Company

upon oath state that the above and foregoing is a true and correct copy of the log of the MC KINLEY #1 well.

Subscribed and sworn to before me this 23 day of January 1962

My Commission Expires: June 14, 1964

Fred Murfin

Mary Ellen Colman

 NOTARY PUBLIC