


Give All Information Completely  
Make Required Affidavit  
Mail or Deliver Report to:  
Conservation Division  
State Corporation Commission  
211 No. Broadway  
Wichita, Kansas

WELL PLUGGING RECORD

NORTH

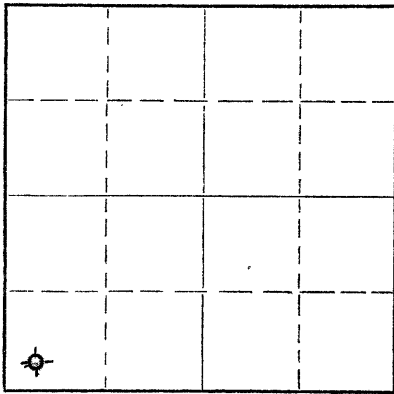

Locate well correctly on above  
Section Plat

Norton County. Sec. 20 Twp. 1 Rge. (E) 24 (W)  
Location as "NE/CNW/SW" or footage from lines SW SW SW  
Lease Owner D. G. Hansen  
Lease Name Anderson Well No. 1  
Office Address Logan, Kansas  
Character of Well (completed as Oil, Gas or Dry Hole) Dry Hole  
Date well completed August 10 19 57  
Application for plugging filed August 10 19 57  
Application for plugging approved August 10 19 57  
Plugging commenced August 10 19 57  
Plugging completed August 10 19 57  
Reason for abandonment of well or producing formation too low structurally

If a producing well is abandoned, date of last production \_\_\_\_\_ 19\_\_\_\_  
Was permission obtained from the Conservation Division or its agents before plugging was commenced? Yes

Name of Conservation Agent who supervised plugging of this well Eldon Petty, Hays, Kansas  
Producing formation \_\_\_\_\_ Depth to top \_\_\_\_\_ Bottom \_\_\_\_\_ Total Depth of Well 3601' Feet  
Show depth and thickness of all water, oil and gas formations.

OIL, GAS OR WATER RECORDS

CASING RECORD

FORMATION	CONTENT	FROM	TO	SIZE	PUT IN	PULLED OUT
				8-5/8"	255'	none

Describe in detail the manner in which the well was plugged, indicating where the mud fluid was placed and the method or methods used in introducing it into the hole. If cement or other plugs were used, state the character of same and depth placed, from \_\_\_\_\_ feet to \_\_\_\_\_ feet for each plug set.

Filled hole with heavy mud up to 250'/  
Set plug. Put in 1/2 sack Hulls and  
20 sacks cement. Filled with heavy  
mud up to 40. Filled to top with 1/2  
sack Hulls and 10 sacks cement.

(If additional description is necessary, use BACK of this sheet)

Name of Plugging Contractor G-G Drilling Co.  
Address 107 Rule Building, Wichita, Kansas

STATE OF KANSAS, COUNTY OF SEDGWICK, ss.

Jay H. Galloway (employee of owner) or (owner or operator) of the above-described well, being first duly sworn on oath, says: That I have knowledge of the facts, statements, and matters herein contained and the log of the above-described well as filed and that the same are true and correct. So help me God.

(Signature) Jay H. Galloway  
107 Rule Bldg.  
(Address)

SUBSCRIBED AND SWORN TO before me this 14th day of August, 19 57

My commission expires May 20, 1959

Vicky Jacobs  
Vicky Jacobs Notary Public.

RECEIVED  
STATE CORPORATION COMMISSION

AUG 15 1957

PLUGGING  
FILE SEC 20 T. 1 R 24 W  
BOOK PAGE 36 LINE 42

CONSERVATION DIVISION  
Wichita, Kansas

15-137-00239-00-00

CONTRACTOR'S WELL LOG

OPERATOR D. G. HANSEN WELL NAME Anderson #1  
 LOCATION SW SW SW Sec. 20-1S-24W RIG NO. 1  
 COUNTY Norton STATE Kansas  
 COMMENCEMENT DATE August 3, 1957 COMPLETION DATE August 10, 1957

LOG OF WELL

Elevation 2417' rotary bushing.  
 All measurements taken from the top of rotary bushing.

FROM	TO	FORMATION	DEVIATION FROM VERTICAL	REMARKS:
0	255	Surface Soil		
255	1100	Shale-Sand		
1100	1250	Sand		
1250	1600	Sand-Shale		
1600	1850	Sand-Red Bed		
1850	1926	Red Bed		
1926	1960	Anhydrite		
1960	2180	Shale-Shells		
2180	2400	Shale-Lime		
2400	2670	Shale-Lime	0° - 2500	
2670	2850	Lime-Shale	0° - 2750	
2850	2955	Lime-Shale		
2955	3050	Lime-Shale	0° - 3000	
3050	3145	Lime-Shale		
3145	3375	Lime-Shale	0° - 3250	
3375	3442	Lime-Shale		
3442	3510	Lime-Shale	0° - 3500	DST 3439-75
3510	3514	Lime-Shale		DST 3468-3514
3514	3569	Lime-Shale		
3569	3586	Granite Wash		
3585	3601	Granite Wash-Granite		DST 3556-69

CASING LEFT IN HOLE AFTER COMPLETION

Set 255' (13 jts.) 8-5/8" OD Surface Casing

STATE OF KANSAS )  
 COUNTY OF SEDGWICK ) ss.

The undersigned hereby certifies that to the best of his knowledge and belief, the above facts are true and correct.

G-G DRILLING CO.

By Jay H. Galloway  
 Jay H. Galloway

Subscribed and sworn to before me this 14th day of August, 1957.

Vicky Jacobs  
 Vicky Jacobs, Notary Public

My commission expires: May 20, 1959

PLUGGING  
 FILE SEC 20 T 1 R 24W  
 BOOK PAGE 36 LINE 42

RECEIVED  
 STATE COMMISSION  
 AUG 15 1957  
 CONSERVATION DIVISION  
 Wichita, Kansas