


WELL PLUGGING RECORD

Give All Information Completely  
Make Required Affidavit  
Mail or Deliver Report to:  
Conservation Division  
State Corporation Commission  
211 No. Broadway  
Wichita, Kansas

NORTH

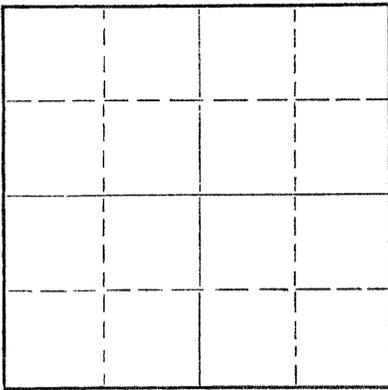

Locate well correctly on above  
Section Plat

Norton County, Sec. 9 Twp. 1-S Rge. 25 (E) (W)  
Location as "NE/CNW/SW" or footage from lines G NE 1/4 of SW 1/4  
Lease Owner Geochemical Surveys  
Lease Name L. E. Jenkins Well No. 1  
Office Address 810 Citizens Nat'l Bank Bldg., Abilene, Texas  
Character of Well (completed as Oil, Gas or Dry Hole) Dry Hole  
Date well completed November 6, 1962 19  
Application for plugging filed November 6, 1962 19  
Application for plugging approved November 6, 1962 19  
Plugging commenced November 7, 1962 19  
Plugging completed November 7, 1962 19  
Reason for abandonment of well or producing formation Dry Hole

If a producing well is abandoned, date of last production None 19  
Was permission obtained from the Conservation Division or its agents before plugging was commenced? Yes - by telephone

Name of Conservation Agent who supervised plugging of this well Mr. Elden Petty, Hays, Kansas  
Producing formation None Depth to top \_\_\_\_\_ Bottom \_\_\_\_\_ Total Depth of Well \_\_\_\_\_ Feet  
Show depth and thickness of all water, oil and gas formations.

OIL, GAS OR WATER RECORDS

CASING RECORD

FORMATION	CONTENT	FROM	TO	SIZE	PUT IN	PULLED OUT
None						

Describe in detail the manner in which the well was plugged, indicating where the mud fluid was placed and the method or methods used in introducing it into the hole. If cement or other plugs were used, state the character of same and depth placed, from \_\_\_\_\_ feet to \_\_\_\_\_ feet for each plug set.

Hole filled with 9.8# drilling mud  
Halliburton pumped cement through drill pipe  
at the following depths:  
20 sxs. at 540'  
20 sxs. at 165'  
10 sxs. at 40' to top of hole.

The above at the instructions of Mr. Elden Petty.

RECEIVED  
STATE CORPORATION COMMISSION  
11-13-1962  
NOV 13 1962

CONSERVATION DIVISION  
Wichita, Kansas

(If additional description is necessary, use BACK of this sheet)  
Name of Plugging Contractor Murfin Drilling Company  
Address Wichita, Kansas

STATE OF Texas, COUNTY OF Taylor, ss.  
H. C. Wilson (employee of owner) or (~~owner or operator~~) of the above-described well, being first duly sworn on oath, says: That I have knowledge of the facts, statements, and matters herein contained and the log of the above-described well as filed and that the same are true and correct. So help me God.

(Signature) H. C. Wilson Production Supt.  
810 Citizens Nat'l Bank Bldg., Abilene, Texas  
(Address)

SUBSCRIBED AND SWORN TO before me this 9th day of November, 1962

My commission expires JUN 1 - 1963

Hugh L. Colbert  
Hugh L. Colbert Notary Public.

