

STATE OF KANSAS  
STATE CORPORATION COMMISSION


Give All Information Completely  
Make Required Affidavit  
Mail or Deliver Report to:  
Conservation Division  
State Corporation Commission  
800 Biting Building  
Wichita, Kansas

15-137-00179-00-00

WELL PLUGGING RECORD

Norton County, Sec. 13 Twp. 1 S Rge. 25 (W)

NORTH

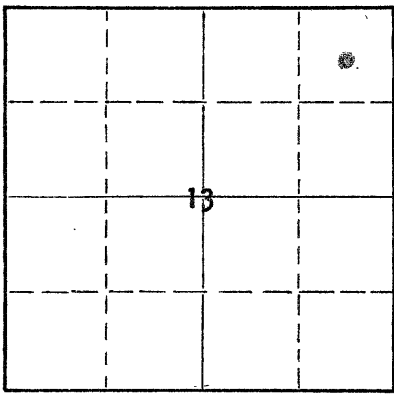

Locate well correctly on above  
Section Plat

Location as "NE/CNW/SW" or footage from lines NE NE  
Lease Owner The British-American Oil Producing Co.  
Lease Name Wilbur Ervin Well No. 1  
Office Address 502 Oil & Gas Building, Oklahoma City, Oklahoma  
Character of Well (completed as Oil, Gas or Dry Hole) Dry Hole  
Date well completed June 16 19 61  
Application for plugging filed June 16 19 61  
Application for plugging approved June 19 19 61  
Plugging commenced June 16 19 61  
Plugging completed June 17 19 61  
Reason for abandonment of well or producing formation Dry

If a producing well is abandoned, date of last production - 19 -  
Was permission obtained from the Conservation Division or its agents before plugging was commenced? Yes

Name of Conservation Agent who supervised plugging of this well A. D. Fabricius  
Producing formation - Depth to top - Bottom - Total Depth of Well 3553 KB Feet  
Show depth and thickness of all water, oil and gas formations.

OIL, GAS OR WATER RECORDS

CASING RECORD

FORMATION	CONTENT	FROM	TO	SIZE	PUT IN	PULLED OUT
Lansing-K.C.	Dry	3277'	3496'	8-5/8"	244.90'	None
Reagan	Dry	3536'	3542'			
Granite	Dry	3542'	TD			

Describe in detail the manner in which the well was plugged, indicating where the mud fluid was placed and the method or methods used in introducing it into the hole. If cement or other plugs were used, state the character of same and depth placed, from \_\_\_\_\_ feet to \_\_\_\_\_ feet for each plug set.

Filled hole with heavy mud; spotted 20-sack plug 400-335' KB, 20-sack plug 240-180' KB, 13-sack plug in top of surface casing, and 2 sacks in rat hole.

RECEIVED  
STATE CORPORATION COMMISSION  
6-26-1961  
JUN 26 1961

CONSERVATION DIVISION  
Wichita, Kansas

(If additional description is necessary, use BACK of this sheet)

Name of Plugging Contractor Garvey Drilling Company  
Address Route 2, Great Bend, Kansas

STATE OF Oklahoma, COUNTY OF Oklahoma, ss.  
George W. Murphy (employee of owner) or (owner or operator) of the above-described well, being first duly sworn on oath, says: That I have knowledge of the facts, statements, and matters herein contained and the log of the above-described well as filed and that the same are true and correct. So help me God.

(Signature) George W. Murphy  
502 Oil & Gas Building, Okla. City, Okla.  
(Address)

SUBSCRIBED AND SWORN TO before me this 24th day of June 19 61

My commission expires 10-10-64

O O Floyd  
Notary Public.

