

STATE OF KANSAS  
STATE CORPORATION COMMISSION

Give All Information Completely  
Make Required Affidavit  
Mail or Deliver Report to:  
Conservation Division  
State Corporation Commission  
211 No. Broadway  
Wichita, Kansas


WELL PLUGGING RECORD

15-137-00008-00-00

Norton County, Sec. 15 Twp. 1S Rge. (X) 25 (W)

Location as "NE/CNW/SW" or footage from lines C NW 1/4 NE 1/4  
Lease Owner Champlin Oil & Refining Co.  
Lease Name Railsback Well No. 1  
Office Address Box 308, Ellinwood, Kansas  
Character of Well (completed as Oil, Gas or Dry Hole) Dry Hole  
Date well completed January 21, 19 62  
Application for plugging filed January 21, 19 62  
Application for plugging approved January 21, 19 62  
Plugging commenced January 11, 19 62  
Plugging completed January 21, 19 62  
Reason for abandonment of well or producing formation \_\_\_\_\_

NORTH

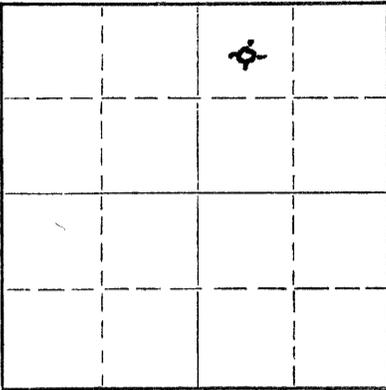

Locate well correctly on above Section Plat

If a producing well is abandoned, date of last production \_\_\_\_\_ 19\_\_\_\_  
Was permission obtained from the Conservation Division or its agents before plugging was commenced? Yes

Name of Conservation Agent who supervised plugging of this well Eldon Petty  
Producing formation \_\_\_\_\_ Depth to top \_\_\_\_\_ Bottom \_\_\_\_\_ Total Depth of Well 3608 Feet  
Show depth and thickness of all water, oil and gas formations.

OIL, GAS OR WATER RECORDS

CASING RECORD

FORMATION	CONTENT	FROM	TO	SIZE	PUT IN	PULLED OUT
				10 3/4"OD	225	None

Describe in detail the manner in which the well was plugged, indicating where the mud fluid was placed and the method or methods used in introducing it into the hole. If cement or other plugs were used, state the character of same and depth placed, from \_\_\_\_\_ feet to \_\_\_\_\_ feet for each plug set.

Filled hole with heavy mud from 3608' TD to 550' and pumped in 20 sacks of cement then filled with mud to 180' and set 1 sack of hulls and 20 sacks of cement then filled hole with mud to 30' and pushed in 2 sacks of hulls and pumped in 10 sacks of cement filling hole to bottom of cellar.

RECEIVED  
STATE CORPORATION COMMISSION  
JAN 29 1962  
CONSERVATION DIVISION  
Wichita, Kansas

(If additional description is necessary, use BACK of this sheet)  
Name of Plugging Contractor Earl Wakefield Drilling Co.  
Address Wichita, Kansas

STATE OF KANSAS, COUNTY OF BARTON, ss.  
J. W. Meyers (employee of owner) or (~~owner or operator~~) of the above-described well, being first duly sworn on oath, says: That I have knowledge of the facts, statements, and matters herein contained and the log of the above-described well as filed and that the same are true and correct. So help me God.

(Signature) [Signature]  
P. O. Box 308, Ellinwood, Kansas  
(Address)

SUBSCRIBED AND SWORN TO before me this 25th day of January, 19 62

[Signature]  
Notary Public.

My commission expires 5-22-62

15-137-00008-00-00

Railsback #1  
C NW $\frac{1}{4}$  NE $\frac{1}{4}$  Sec. 15-18-25W  
Norton County, Kansas

FORMATION LOG

0 -	58	Soil Clay Sdy.
58 -	231	Shale & Lime
231 -	1350	Shale & Shells
1350 -	1400	Shale
1400 -	1460	Sand
1460 -	2115	Shale & Shells
2115 -	3260	Lime & Shale
3260 -	3290	Lime
3290 -	3483	Lime & Shale
3483 -	3565	Lime, Shale & Sand
3565 -	3576	Sand
3576 -	3608	Shale & Lime
3608 -	TD	

**RECEIVED**  
STATE CORPORATION COMMISSION

JAN 2 1962

CONSERVATION DIVISION  
Wichita, Kansas