

STATE OF KANSAS  
STATE CORPORATION COMMISSION


Give All Information Completely  
Make Required Affidavit  
Mail or Deliver Report to:  
Conservation Division  
State Corporation Commission  
800 Bitting Building  
Wichita, Kansas

WELL PLUGGING RECORD

15-137-00178-00-00

Norton County, Sec. 24 Twp. 1S Rge. (E) 25 (W)

Location as "NE/CNW/SW" or footage from lines C SE NE  
Lease Owner The British-American Oil Producing Co.  
Lease Name H. A. Meyers "C" Well No. 1  
Office Address 502 Oil & Gas Building, Oklahoma City, Oklahoma  
Character of Well (completed as Oil, Gas or Dry Hole) Dry Hole  
Date well completed 7-17 1961  
Application for plugging filed 7-18 1961  
Application for plugging approved 7-19 1961  
Plugging commenced 7-18 1961  
Plugging completed 7-18 1961  
Reason for abandonment of well or producing formation dry hole

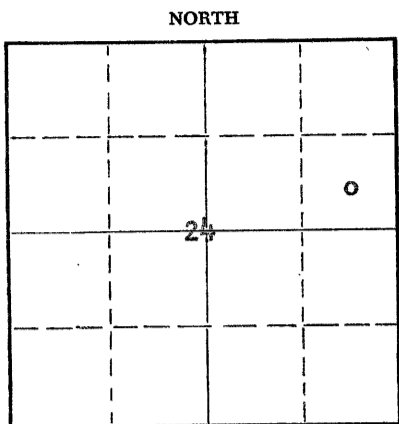

Locate well correctly on above  
Section Plat

If a producing well is abandoned, date of last production        19        
Was permission obtained from the Conservation Division or its agents before plugging was commenced? Yes

Name of Conservation Agent who supervised plugging of this well Eldon Petty  
Producing formation None Depth to top        Bottom        Total Depth of Well 3617 KB Feet  
Show depth and thickness of all water, oil and gas formations.

OIL, GAS OR WATER RECORDS

CASING RECORD

FORMATION	CONTENT	FROM	TO	SIZE	PUT IN	PULLED OUT
None - dry hole						

Describe in detail the manner in which the well was plugged, indicating where the mud fluid was placed and the method or methods used in introducing it into the hole. If cement or other plugs were used, state the character of same and depth placed, from        feet to        feet for each plug set.

Filled hole with heavy mud. RU Howco and spotted 20-sack plug cement at 496', 20-sack plug cement at 250', and 10-sack plug in top of surface casing.

**RECEIVED**  
STATE CORPORATION COMMISSION  
07-28 1961  
JUL 28 1961  
CONSERVATION DIVISION  
Wichita, Kansas

(If additional description is necessary, use BACK of this sheet)

Name of Plugging Contractor Garvey Drilling Company  
Address Route 2, Great Bend, Kansas

STATE OF Oklahoma, COUNTY OF Oklahoma, ss.  
John C. Thrash, Jr. (employee of owner) or (owner or operator) of the above-described well, being first duly sworn on oath, says: That I have knowledge of the facts, statements, and matters herein contained and the log of the above-described well as filed and that the same are true and correct. So help me God.

(Signature) John C. Thrash Jr.  
502 Oil & Gas Building, Oklahoma City, Okla.  
(Address)

SUBSCRIBED AND SWORN TO before me this 25th day of July, 1961

My commission expires August 19, 1964

Robert V. Halp  
Notary Public.

