

CARD MUST BE TYPED

State of Kansas
NOTICE OF INTENTION TO DRILL
(see rules on reverse side)

CARD MUST BE SIGNED

Starting Date: 11 12 84
month day year ~~350~~

API Number 15- 137-20,348-00-00

OPERATOR: License # 8301
Name Stoepfelwerth Drilling Inc., &
Address Box 978 Advanced Resources
City/State/Zip McCook, NB 69001
Contact Person Jack Lowry
Phone 308 345 1766

..... SE SE Sec .. 20 Twp .. 1 S, Rge .. 23. East
(location) West

..... 660 Ft North from Southeast Corner of Section
..... 660 Ft West from Southeast Corner of Section
(Note: Locate well on Section Plat on reverse side)

CONTRACTOR: License # 8301
Name .. Stoepfelwerth Drilling, Inc.
City/State ... same as above

Nearest lease or unit boundary line 660 feet.
County Norton

Lease Name Richard L Wyatt Well# 16-20

Domestic well within 330 feet : yes no

Municipal well within one mile : yes no

Well Drilled For: Oil Swd
 Gas Inj Pool Ext.
 OWWO Expl Wildcat

Well Class: XXX Inj Pool Ext.

Type Equipment: XXX Med Rotary Air Rotary Cable

Depth to Bottom of fresh water 150 feet

Lowest usable water formation Dakota

Depth to Bottom of usable water ~~200~~ 1200 feet

Surface pipe by Alternate : 1 2 XX

Surface pipe to be set 230 feet

Conductor pipe if any required feet

Ground surface elevation feet MSL

This Authorization Expires 5-9-85

Approved By 11-9-84 *R*

If OWWO: old well info as follows:

Operator

Well Name

Comp Date Old Total Depth

Projected Total Depth 3700 feet

Projected Formation at TD


Expected Producing Formations

I certify that we will comply with K.S.A. 55-101, et seq., plus eventually plugging hole to K.C.C. specifications.

Date 11-9-84. Signature of Operator or Agent *Raquel Robles* Title As. Agent

**Must be filed with the K.C.C. five (5) days prior to commencing well
 This card void if drilling not started within six (6) months of date received by K.C.C.**

Wichita, Kansas
 CONSERVATION DIVISION
 11-9-84
 NOV 9 1984
A Regular Section of Land
 1 Mile - 5,280 Ft.
 STATE CORPORATION COMMISSION
 RECEIVED

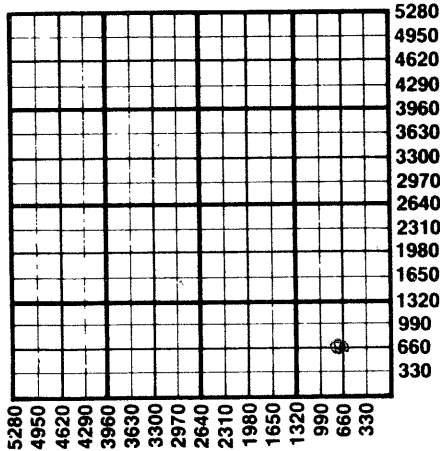

Important procedures to follow :

1. Notify District office before setting surface casing.
2. Set surface casing by circulating cement to the top.
3. File completion forms ACO-1 with K.C.C. within 90 days of well completion, following instructions on ACO-1, side 1, and including copies of wireline logs.
4. Notify District office 48 hours prior to old well workover or re-entry.
5. Prior to plugging, prepare a plugging plan, then obtain agreement from the appropriate district office for an approved plugging plan.
6. Submit plugging report (CP-4) to K.C.C. after plugging is completed.
7. Obtain an approved injection docket number before disposing of salt water.
8. Notify K.C.C. within 10 days when injection commences or terminates.
9. If an alternate 2 completion, cement in the production pipe from below any usable water to surface within 120 days of spud date.

**State Corporation Commission of Kansas
 Conservation Division
 200 Colorado Derby Building
 Wichita, Kansas 67202
 (316) 263-3238**