


Give All Information Completely
Make Required Affidavit
Mail or Deliver Report to:
Conservation Division
State Corporation Commission
212 No. Market
Wichita, Kansas

WELL PLUGGING RECORD

Decatur County, Sec. 10 Twp. 1S Rge. (E) 26 (W)

Location as "NE/CNW/SW" or footage from lines. NE NE NW
Lease Owner Aylward Drilling Co.
Lease Name Huff Well No. 1
Office Address 909 First National Bank Bldg., Wichita, Kansas
Character of Well (completed as Oil, Gas or Dry Hole) Dry Hole
Date well completed November 22, 19 68
Application for plugging filed (verbally) " 19 "
Application for plugging approved " " 19 "
Plugging commenced November 22, 19 68
Plugging completed " " 19 "
Reason for abandonment of well or producing formation _____

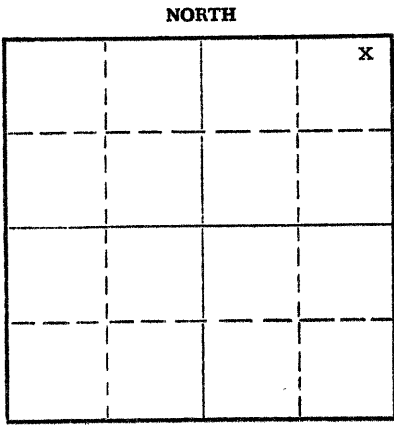

Locate well correctly on above Section Plat

If a producing well is abandoned, date of last production _____ 19 _____
Was permission obtained from the Conservation Division or its agents before plugging was commenced? Yes (verbally)

Name of Conservation Agent who supervised plugging of this well Bill Nichols
Producing formation _____ Depth to top _____ Bottom _____ Total Depth of Well 3577 Feet
Show depth and thickness of all water, oil and gas formations.

OIL, GAS OR WATER RECORDS

CASING RECORD

FORMATION	CONTENT	FROM	TO	SIZE	PUT IN	PULLED OUT

Describe in detail the manner in which the well was plugged, indicating where the mud fluid was placed and the method or methods used in introducing it into the hole. If cement or other plugs were used, state the character of same and depth placed, from _____ feet to _____ feet for each plug set.

Set 1st plug @ 1400' w/50 sx. cement;
Set 2nd plug @ 260' w/15 sx. cement;
Set top plug @ 40' w/10 sx. cement.
Job completed 5:30 a.m. 11-22-68.

RECEIVED
STATE CORPORATION COMMISSION
NOV 27 1968
CONSERVATION DIVISION
Wichita, Kansas
11-27-1968

(If additional description is necessary, use BACK of this sheet)
Name of Plugging Contractor Abercrombie Drilling, Inc.
Address Great Bend, Kansas

STATE OF KANSAS, COUNTY OF SEDGWICK, ss.
A. L. Abercrombie (employee of owner) or (owner or operator) of the above-described well, being first duly sworn on oath, says: That I have knowledge of the facts, statements, and matters herein contained and the log of the above-described well as filed and that the same are true and correct. So help me God.

(Signature) A. L. Abercrombie
801 Union Center, Wichita, Kansas 67202
(Address)

SUBSCRIBED AND SWORN TO before me this 22nd day of November, 19 68

My commission expires July 15, 1972
Sue J. Blunck
Sue J. Blunck, Notary Public.

CONTRACTOR'S WELL LOG

15-039-20074-00-00

OWNER: Aylward Drilling, Inc.
 CONTRACTOR: Abercrombie Drilling, Inc.
 NAME: HUFF #1
 LOCATION: NE NE NW, Sec. 10-1S-26W
 Decatur County, Kansas
 GEOLOGIST: Jack K. Wharton
 COMMENCED: November 16, 1968
 COMPLETED: November 22, 1968

0	140	Clay, Sand, & Pyrite
140	400	Shale
400	1375	Shale & Shells
1375	1638	Shale
1638	1740	Sand
1740	1959	Red Shale
1959	1989	Anhydrite
1989	2320	Shale
2320	2775	Shale & Lime
2775	2918	Lime & Shale
2918	3213	Shale & Lime
3213	3480	Lime & Shale
3480	3577	Lime
	3577	Rotary Total Depth

Drilled 252' of 9" surface hole and set 7" csg. @250' w/90 sx. Sunset cement. Cement circulated. Plug was down 1:00 a.m., 11-16-68. Dry & Abandoned.

FORMATION SAMPLE TOPS			ELEVATION
T/Anhydrite	1959	(+ 527)	2486 K. B.
Heebner	3237	(- 751)	2484 D. F.
Lansing	3273	(- 787)	2478 G. L.
Base/K.C.	3511	(-1025)	
Reagan Sand	3556	(-1070)	
Granite Wash	3575	(-1089)	
Rotary T. D.	3577	(-1091)	

RECEIVED
 STATE CORPORATION COMMISSION
 NOV 27 1968
 CONSERVATION DIVISION
 Wichita, Kansas
 11-27-1968


STATE OF KANSAS)
) SS
 COUNTY OF SEDGWICK)

A. L. Abercrombie, President of Abercrombie Drilling, Inc., does hereby state that the above and foregoing is a true and correct copy of the log of the #1 HUFF, located in the NE NE NW, Sec. 10-1S-26W, Decatur County, Kansas.

ABERCROMBIE DRILLING, INC.

A. L. Abercrombie
 A. L. Abercrombie, President

Sworn to before me, a Notary Public, in and for the County of Sedgwick, State of Kansas, as of this 25th day of November, 1968.

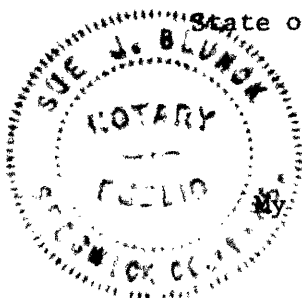

Sue J. Blunck
 Sue J. Blunck, Notary Public

Commission Expires:

July 15, 1972