

CARD MUST BE TYPED

State of Kansas

CARD MUST BE SIGNED

NOTICE OF INTENTION TO DRILL

(see rules on reverse side)

Starting Date 11-24-86 month day year

API Number 15- 039-20,800-00-00

OPERATOR: License # 4629

NW SW SW Sec. 17 Twp. 1 S, Rg. 26 East West

Name Brito Oil Company, Inc.

Address 200 E. First, Suite 413

City/State/Zip Wichita, KS 67202

Contact Person Raul F. Brito

Phone (316) 263-8787

990 Ft. from South Line of Section

4950 Ft. from East Line of Section

(Note: Locate well on Section Plat on reverse side)

Nearest lease or unit boundary line 990 feet

County Decatur

Lease Name Wiggins Well # 1

Ground surface elevation feet MSL

Domestic well within 330 feet: yes X no

Municipal well within one mile: yes X no

Depth to bottom of fresh water 60

Depth to bottom of usable water 1100

Surface pipe by Alternate: 1 2 X

Surface pipe planned to be set 250

Conductor pipe required None

Projected Total Depth 3500 feet

Formation Granite Wash

CONTRACTOR: License # 5422

Name Abercrombie Drilling, Inc.

City/State Wichita, Kansas

Well Drilled For: Well Class: Type Equipment:

X Oil SWD Infield X Mud Rotary

Gas Inj Pool Ext Air Rotary

OWWO Expl Wildcat Cable

If OWWO: old well info as follows:

Operator

Well Name

Comp Date Old Total Depth

I certify that well will comply with K.S.A. 55-101, et seq., plus eventually plugging hole to KCC specifications.

Date 11-12-86 Signature of Operator or Agent





Title President

For KCC Use: Conductor Pipe Required feet; Minimum Surface Pipe Required

This Authorization Expires 5-19-87

200 feet per Alt. 1

Approved By 11-19-86


Signature

Must be filed with the K.C.C. five (5) days prior to commencing well  
This card void if drilling not started within six (6) months of date received by K.C.C.

**Important procedures to follow:**

1. Notify District office before setting surface casing.
2. Set surface casing by circulating cement to the top.
3. File completion forms ACO-1 with K.C.C. within 90 days of well completion, following instructions on ACO-1, side 1, and including copies of wireline logs.
4. Notify District office 48 hours prior to old well workover or re-entry.
5. Prior to filing Intent, prepare a proposed plugging plan in case well is D & A, then obtain approval of plan when calling district office prior to setting surface pipe.
6. Submit plugging report (CP-4) to K.C.C. after plugging is completed.
7. Obtain an approved injection docket number before disposing of salt water.
8. Notify K.C.C. within 10 days when injection commences or terminates.
9. If an alternate 2 completion, cement in the production pipe from  
any usable water to surface within 120 days of spud date.

**A Regular Section of Land**  
1 Mile = 5,280 Ft.

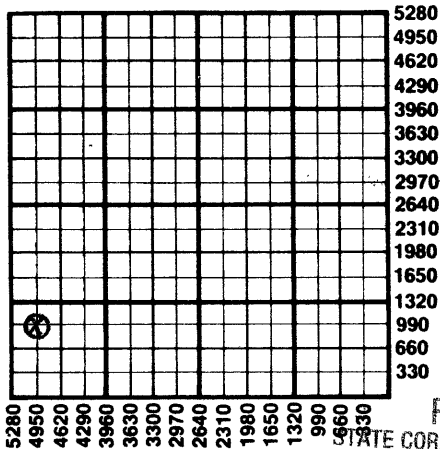

RECEIVED  
STATE CORPORATION COMMISSION

NOV 19 1986  
11-19-86  
CONSERVATION DIVISION  
Wichita, Kansas

State Corporation Commission of Kansas  
Conservation Division  
200 Colorado Derby Building  
Wichita, Kansas 67202  
(316) 263-3238