

STATE OF KANSAS
STATE CORPORATION COMMISSION

15-137-00192-00700

WELL PLUGGING RECORD

Give All Information Completely
Make Required Affidavit
Mail or Deliver Report to:
Conservation Division
State Corporation Commission
800 Bittling Building
Wichita, Kansas

Norton County. Sec. 32 Twp. 1 Rge. (E) 23 (W)

Location as "NE/CNW/SW" or footage from lines NE NE NE

Lease Owner Jones, Shelburne & Farmer, Inc.

Lease Name MARY BROWNE Well No. 1

Office Address Russell, Kansas

Character of Well (completed as Oil, Gas or Dry Hole) Dry

Date well completed 10-20 19 55

Application for plugging filed 10-20 19 55

Application for plugging approved 10-20 19 55


Plugging commenced 10-20 19 55

Plugging completed 10-20 19 55

Reason for abandonment of well or producing formation Dry

If a producing well is abandoned, date of last production _____ 19 _____

Was permission obtained from the Conservation Division or its agents before plugging was commenced? Yes

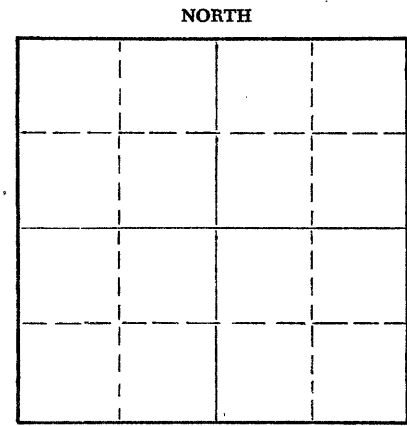

Locate well correctly on above Section Plat

Name of Conservation Agent who supervised plugging of this well Eldon Petty

Producing formation _____ Depth to top _____ Bottom _____ Total Depth of Well 3738 Feet

Show depth and thickness of all water, oil and gas formations.

OIL, GAS OR WATER RECORDS

CASING RECORD

FORMATION	CONTENT	FROM	TO	SIZE	PUT IN	PULLED OUT
				8-5/8"	236	None

Describe in detail the manner in which the well was plugged, indicating where the mud fluid was placed and the method or methods used in introducing it into the hole. If cement or other plugs were used, state the character of same and depth placed, from _____ feet to _____ feet for each plug set.

1. Filled hole with heavy mud
2. Pushed plug to 230'
3. Dumped 1/2 sacks hulls on top of plug
4. Mixed 15 sacks cement and dumped on top of hulls
5. Filled hole to top
6. Pushed plug to 40'
7. Dumped in 1/2 sack hulls
8. Mixed 10 sacks cement and filled hole to top with same.

11-2-55

(If additional description is necessary, use BACK of this sheet)

Name of Plugging Contractor Jones, Shelburne & Farmer, Inc.

Address Russell, Kansas

STATE OF Kansas, COUNTY OF Russell, ss.

JOHN O. FARMER

(employee of owner) or (owner or operator) of the above-described

well, being first duly sworn on oath, says: That I have knowledge of the facts, statements, and matters herein contained and the log of the above-described well as filed and that the same are true and correct. So help me God.


(Signature)

John O. Farmer
Russell, Kansas
(Address)

SUBSCRIBED AND SWORN TO before me this 31st day of October, 19 55

Lucille Kennedy
Notary Public.

My commission expires October 11, 1958

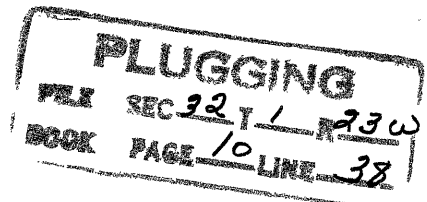


OPERATOR Jones, Shelburne & Farmer, Inc.

15-137-00192-00-00

FORMATION RECORD

ADDRESS Russell, Kansas

Give detailed description and thickness of all formations drilled through, contents of sand, whether dry, water, oil or gas.

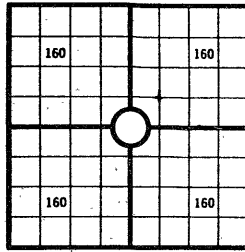23
RGE. 1
TWP. 32
SEC. 32
COUNTY Norton
WELL NO. 1
MAY BE KNOWN640 Acres
N

Locate well correctly

COUNTY Norton SEC. 32 TWP. 1 RGE. 23
 COMPANY OPERATING Jones, Shelburne & Farmer, Inc.
 OFFICE ADDRESS Russell, Kansas
 FARM NAME Mary Brown WELL NO. 1
 DRILLING STARTED 10-7-55 DRILLING FINISHED 10-29-55
 DATE OF FIRST PRODUCTION COMPLETED
 WELL LOCATED NE 1/4 NE 1/4 NE 1/4 North of South
 Line and ft. East of West Line of Quarter Section
 Elevation (Relative to sea level) DERRICK FLOOR 2458 GROUND
 CHARACTER OF WELL (Oil, gas or dryhole) Dry

OIL OR GAS SANDS OR ZONES

Name	From	To	Name	From	To
1			4		
2			5		
			6		

Perforating Record If Any

Shot Record

Formation	From	To	No. of Shots	Formation	From	To	Size of Shot

CASING RECORD

Size	Wt	Amount Set				Amount Pulled				Packer Record	
		Thds.	Make	Ft.	In.	Ft.	In.	Size	Length	Depth Set	Make
8	5/8			236							

Liner Record: Amount _____ Kind _____ Top _____ Bottom _____

CEMENTING AND MUDDING

Size	Amount Set		Sacks Cement	Chemical		Method of Cementing	Amount	Mudding Method	Results (See Note)
	Ft.	In.		Gal.	Make				
8	5/8	236							

Note: What method was used to protect sands if outer strings were pulled? _____

NOTE: Were bottom hole plugs used? _____ If so, state kind, depth set and results obtained _____

TOOLS USED

Rotary Tools were used from _____ feet to _____ feet to _____ feet, and from _____ feet to _____ feet, and from _____ feet to _____ feet.

Type Rig _____

INITIAL PRODUCTION TEST

Describe initial test: whether by flow through tubing or casing or by pumping _____

Amount of Oil Production _____ bbls. Size of choke, if any _____ Length of test _____ Water
Production _____ bbls. Gravity of oil _____ Type of Pump if pump is used, describe _____

Formation	Top	Bottom	Formation	Top	Bottom
Surface	0	236			
Shale	236	700			
Shale sand & shale	700	1350			
Shale & shells	1350	1605			
Sand	1605	1715			
Shale & shells	1715	1870			
Redbed & shale	1870	1993			
Anhydrite	1993	2028			
Shale & shells	2028	2565			
Shale & lime	2565	3465			
Lime & shale	3465	3665			
Shale & lime	3665	3720			
Granite Wash	3720	3735			
Granite	3735	3738			

TOPS:

Elev 2460
 Heebner 3426
 Toronto 3460
 Lansing 3471
 BKC 3661
 Granite Wash 3708
 Granite 3730
 T.D. 3738

I, the undersigned, being first duly sworn upon oath, state that this well record is true, correct and complete according to the records of this office and to the best of my knowledge and belief.

John W. Ferrell
 Name and title of representative of company

Subscribed and sworn to before me this 26th day of October, 19 55
 My Commission expires July 14, 1958
Lannie Pace
 Notary Public.