


15-137-20060-00-00

Give All Information Completely
Make Required Affidavit
Mail or Deliver Report to:
Conservation Division
State Corporation Commission
212 No. Market
Wichita, Kansas 67202

WELL PLUGGING RECORD

Norton County, Sec. 21 Twp. 1 Rge. 23 (E) (W)

Location as "NE/CNW%SW%" or footage from lines SW SW SE
Lease Owner Will P. Ash
Lease Name Wyatt Well No. 1
Office Address 360 Sutton Place Building Wichita, Kansas 67202
Character of Well (completed as Oil, Gas or Dry Hole) _____
Date well completed _____ 19____
Application for plugging filed 10-13-70 19____
Application for plugging approved 10-14-70 19____
Plugging commenced 11-2-70 19____
Plugging completed 11-23-70 19____
Reason for abandonment of well or producing formation _____

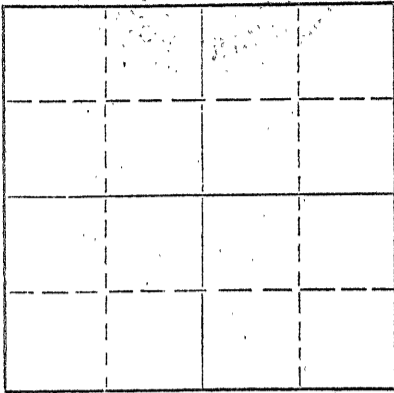

Locate well correctly on above Section Plat

If a producing well is abandoned, date of last production _____ 19____
Was permission obtained from the Conservation Division or its agents before plugging was commenced? Yes

Name of Conservation Agent who supervised plugging of this well Bill Nichols
Producing formation _____ Depth to top _____ Bottom _____ Total Depth of Well 3644 Feet
Show depth and thickness of all water, oil and gas formations.

OIL, GAS OR WATER RECORDS

CASING RECORD

FORMATION	CONTENT	FROM	TO	SIZE	PUT IN	PULLED OUT
				8 5/8	218	None
				4 1/2	3617	912'.38
RECEIVED STATE CORPORATION COMMISSION DEC 7 - 1970 CONSERVATION DIVISION Wichita, Kansas						

Describe in detail the manner in which the well was plugged, indicating where the mud fluid was placed and the method or methods used in introducing it into the hole. If cement or other plugs were used, state the character of same and depth placed, from _____ feet to _____ feet for each plug set.

Moved unit, and set in. Pushed plug to 3400'; dumped 10 gallons of sand and 5 sacks of cement. Had 10" tension at 1600 psi. Shot casing at 3004', 2516', 2023', 1708' and 1527'. Worked casing. Shot casing at 1428', 1323', 1244', 1148', 1053' and 927'. Laid down 28 joints. Load trailer and tore down. Allied squeezed well with 3 sacks of hulls, 30 sacks of gel and 135 sacks of pozmix cement.

(If additional description is necessary, use BACK of this sheet)


Name of Plugging Contractor Forbes Casing Pulling Company, Inc.
Address P. O. Box 221 Great Bend, Kansas 67530

STATE OF Kansas, COUNTY OF Barton, ss.
James W. Rockhold (employee of owner) or (owner or operator) of the above-described

well, being first duly sworn on oath, says: That I have knowledge of the facts, statements, and matters herein contained and the log of the above-described well as filed and that the same are true and correct. So help me God.

(Signature) James W. Rockhold
P. O. Box 221 Great Bend, Kansas
(Address)

Subscribed AND Sworn to before me this 4 day of December, 19 70

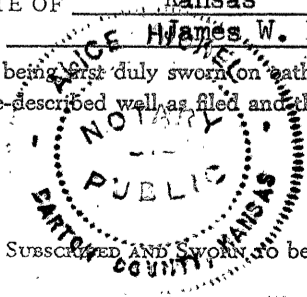

My commission expires May 27, 1973

John Likel Notary Public.