


WELL PLUGGING RECORD

Give All Information Completely
Make Required Affidavit
Mail or Deliver Report to:
Conservation Division
State Corporation Commission
800 Bitting Building
Wichita, Kansas

Norton County. Sec. 36 Twp. 1 Rge. (E) 24 (W)
Location as "NE/CNW/SW" or footage from lines NE NE NW
Lease Owner Jones, Shelburne & Farmer, Inc.
Lease Name J. G. BROWN Well No. 1
Office Address Russell, Kansas
Character of Well (completed as Oil, Gas or Dry Hole) Dry
Date well completed 10-29 1955
Application for plugging filed 10-29 1955
Application for plugging approved 10-29 1955
Plugging commenced 10-29 1955
Plugging completed 10-29 1955
Reason for abandonment of well or producing formation Dry

NORTH

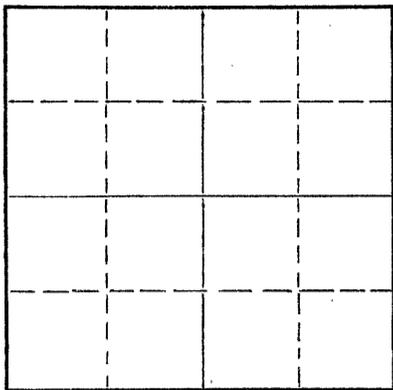

Locate well correctly on above
Section Plat

If a producing well is abandoned, date of last production _____ 19____
Was permission obtained from the Conservation Division or its agents before plugging was commenced? Yes

Name of Conservation Agent who supervised plugging of this well Eldon Petty
Producing formation _____ Depth to top _____ Bottom _____ Total Depth of Well 3608 Feet
Show depth and thickness of all water, oil and gas formations.

OIL, GAS OR WATER RECORDS

CASING RECORD

FORMATION	CONTENT	FROM	TO	SIZE	PUT IN	PULLED OUT
				8-5/8"	190	None

Describe in detail the manner in which the well was plugged, indicating where the mud fluid was placed and the method or methods used in introducing it into the hole. If cement or other plugs were used, state the character of same and depth placed, from _____ feet to _____ feet for each plug set.

1. Filled hole with heavy mud
2. Pushed plug to 185'
3. Dumped 1/2 sack hulls on top of plug
4. Mixed 15 sacks cement and dumped on top of hulls
5. Filled hole to top
6. Pushed plug to 40'
7. Dumped in 1/2 sack hulls
8. Mixed 10 sacks cement and filled hole to top with same

RECEIVED
STATE CORPORATION COMMISSION
NOV 12 1955

(If additional description is necessary, use BACK of this sheet)
Name of Plugging Contractor Jones, Shelburne & Farmer, Inc.
Address Russell, Kansas

STATE OF Kansas, COUNTY OF Russell, ss.
JOHN O. FARMER (employee of owner) or (owner or operator) of the above-described well, being first duly sworn on oath, says: That I have knowledge of the facts, statements, and matters herein contained and the log of the above-described well as filed and that the same are true and correct. So help me God.

(Signature) John O. Farmer
Russell, Kansas (Address)

SUBSCRIBED AND SWORN TO before me this 3rd day of November, 19 55
Lucille Loney
Notary Public.

My commission expires 10-11-58

PLUGGING
FILE SEC 36 T 1 R 24 W
BOOK PAGE 12 LINE 4

OPERATOR Jones, Shelburne & Farmer, Inc.ADDRESS Russell, Kansas

FORMATION RECORD

Give detailed description and thickness of all formations drilled through, contents of sand, whether dry, water, oil or gas.

640 Acres
NCOUNTY Norton SEC 36 TWP 1 RGE 24COMPANY OPERATING Jones, Shelburne & Farmer, Inc.OFFICE ADDRESS Russell, KansasFARM NAME J. C. Brown WELL NO. 1DRILLING STARTED 10-22-55 DRILLING FINISHED 10-28-55

DATE OF FIRST PRODUCTION _____ COMPLETED _____

WELL LOCATED NE $\frac{1}{4}$ NE $\frac{1}{4}$ NW $\frac{1}{4}$ North of South

Line and _____ ft. East of West Line of Quarter Section

Elevation (Relative to sea level) DERRICK FLOOR 2686 GROUND _____CHARACTER OF WELL (Oil, gas or dryhole) Dry

OIL OR GAS SANDS OR ZONES

Name	From	To	Name	From	To

Operating Record If Any

Shot Record

Formation	From	To	No. of Shots	Formation	From	To	Size of Shot

CASING RECORD

Size	Amount Set				Amount Pulled				Packer Record		
	Wt.	Thds.	Make	Ft.	In.	Ft.	In.	Size	Length	Depth Set	Make
8 5/8				190							

Liner Record Amount _____ Kind _____ Top _____ Bottom _____

CEMENTING AND MUDDING

Size	Amount Set		Sacks Cement	Chemical		Method of Cementing	Amount	Mudding Method	Results (See Note)
	Ft.	In.		Gal.	Make				
8 5/8	190		130						

Note: What method was used to protect sands if outer strings were pulled?

NOTE: Were bottom hole plugs used? If so, state kind, depth set and results obtained

TOOLS USED

Rotary Tools were used from _____ feet to _____ Cable tools were used from _____ feet to _____ feet, and from _____ feet to _____ feet, and from _____ feet to _____ feet to _____
Type Rig _____

INITIAL PRODUCTION TEST

Describe initial test: whether by flow through tubing or casing or by pumping _____

Amount of Oil Production _____ bbls. Size of choke, if any _____ Length of test _____ Water

Production _____ bbls. Gravity of oil _____ Type of Pump if pump is used, describe _____

I, the undersigned, being first duly sworn upon oath, state that this well record is true, correct and complete according to the records of this office and to the best of my knowledge and belief.

John W. Farmer Vice-Pres.
Name and title of representative of company

Subscribed and sworn to before me this 3rd day of November, 1955
My Commission expires July 14, 1958 *Dannie Pratt*
Notary Public.

TOPS:

Elev 2388

Heebner 3315

Lansing 3362

BKC 3551

Gorham Sand 3594

Weathered Arb. 3603

Granite Wash 3604

T.D. 3608

15-137-00191-00-00

FARM NAME J. C. Brown WELL NO. 1 COUNTY Norton SEC 36 TWP 1 RGE 24