


Give All Information Completely
Make Required Affidavit
Mail or Deliver Report to:
Conservation Division
State Corporation Commission
212 North Market, Insurance Bldg.
Wichita, Kansas

WELL PLUGGING RECORD

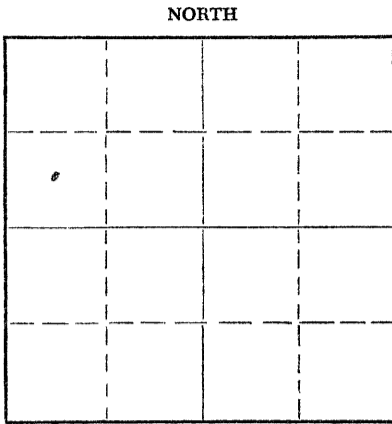

Locate well correctly on above
Section Plat

DECATUR County. Sec. 11 Twp. 1 Rge. 26 (E) W (W)
Location as "NE/CNW/SW" or footage from lines C SW NW
Lease Owner KEITH F. WALKER
Lease Name KNUTSON Well No. 1
Office Address P.O. BOX 1725, ARDMORE, OKLAHOMA
Character of Well (completed as Oil, Gas or Dry Hole) DRY HOLE
Date well completed MAY 24 19 63
Application for plugging filed " 19 63
Application for plugging approved " 19 63
Plugging commenced " 19 63
Plugging completed " 19 63
Reason for abandonment of well or producing formation DRY HOLE

If a producing well is abandoned, date of last production 19
Was permission obtained from the Conservation Division or its agents before plugging was commenced? YES

Name of Conservation Agent who supervised plugging of this well BILL NICHOLS
Producing formation _____ Depth to top _____ Bottom _____ Total Depth of Well 3606 Feet
Show depth and thickness of all water, oil and gas formations.

OIL, GAS OR WATER RECORDS

CASING RECORD

FORMATION	CONTENT	FROM	TO	SIZE	PUT IN	PULLED OUT
		0	215	7"	206	0

Describe in detail the manner in which the well was plugged, indicating where the mud fluid was placed and the method or methods used in introducing it into the hole. If cement or other plugs were used, state the character of same and depth placed, from _____ feet to _____ feet for each plug set.

PLUGGED WITH 15 SACKS CEMENT @ 550',
15 SACKS CEMENT @ 200', 10 SACKS CEMENT
@ 40' TO SURFACE.

RECEIVED
STATE CORPORATION COMMISSION

JUN 24 1963

6-24-1963

CONSERVATION DIVISION
Wichita, Kansas

(If additional description is necessary, use BACK of this sheet)

Name of Plugging Contractor CHEMICAL & TECHNICAL SERVICES, INC.
Address P.O. BOX D, HILL CITY, KANSAS

STATE OF KANSAS, COUNTY OF GRAHAM, ss.
D. F. MCCARTHY (employee of owner) or (owner or operator) of the above-described well, being first duly sworn on oath, says: That I have knowledge of the facts, statements, and matters herein contained and the log of the above-described well as filed and that the same are true and correct. So help me God.

(Signature) D. F. McCarthy
P.O. BOX D, HILL CITY, KANSAS
(Address)

SUBSCRIBED AND SWORN TO before me this 21st day of June, 19 63

My commission expires My Commission Expires January 23, 1964 Carroll Preyer Notary Public.

