


15-039-20392-00-00

STATE OF KANSAS  
STATE CORPORATION COMMISSION

WELL PLUGGING RECORD

Give All Information Completely  
Make Required Affidavit  
Mail or Deliver Report to  
Conservation Division  
State Corporation Comm.  
245 North Water  
Wichita, KS 67202

Decatur County. Sec. 11 Twp. 1 S Rge. 26 ~~E/W~~  
Location as "NE/CNW $\frac{1}{4}$ SW $\frac{1}{4}$ " or footage from lines  
C NE/4 NW/4  
Lease Owner White Eagle Petroleum Company c/o Robert A. Mason  
Lease Name Huff "F" Well No. 1  
Office Address 2560 Liberty Tower, Oklahoma City, Ok. 73102  
Character of Well (Completed as Oil, Gas or Dry Hole)

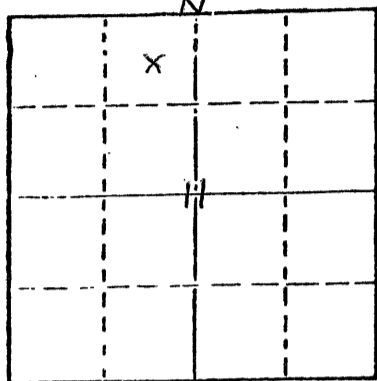

Locate well correctly on above  
Section Plat

Dry hole  
Date Well completed June 14, 1977  
Application for plugging filed (verbally) June 14, 1977  
Application for plugging approved (verbally) June 14, 1977  
Plugging commenced June 14, 1977  
Plugging completed July 5, 1977  
Reason for abandonment of well or producing formation  
Lost circulation; unable to drill ahead.  
If a producing well is abandoned, date of last production 19

Was permission obtained from the Conservation Division or  
its agents before plugging was commenced? Yes

Name of Conservation Agent who supervised plugging of this well Gilbert Balthazor  
Producing formation \_\_\_\_\_ Depth to top \_\_\_\_\_ Bottom \_\_\_\_\_ Total Depth of Well 1611  
Show depth and thickness of all water, oil and gas formations.

OIL, GAS OR WATER RECORDS

CASING RECORD

FORMATION	CONTENT	FROM	TO	SIZE	PUT IN	PULLED OUT
				8-5/8	231	None

Describe in detail the manner in which the well was plugged, indicating where the mud fluid was placed and the method or methods used in introducing it into the hold. If cement or other plugs were used, state the character of same and depth placed, from 231 feet to surface feet for each plug set. Bridged hole at 210' with wooden plug. 1/2 sack Hulls and 50 lbs. Dry cement on top of plug. Filled hole with 3 yards of Redi-Mix cement poured into hole 1 yard at a time. Let cement harden and then poured another quantity of cement at a later date. In this manner, a solid plug of cement was set from 210' to the surface.

RECEIVED  
STATE CORPORATION COMMISSION  
JUL 11 1977  
CONSERVATION DIVISION  
Wichita, Kansas

(If additional description is necessary, use BACK of this sheet)

Name of Plugging Contractor Abercrombie Drilling, Inc.


STATE OF KANSAS COUNTY OF SEDGWICK, ss.  
Jack L. Partridge, Ass't. Secretary-Treasurer (employee of owner) or (owner or operator)  
of the above-described well, being first duly sworn on oath, says: That I have knowledge of  
the facts, statements, and matters herein contained and the log of the above-described well  
as filed and that the same are true and correct. So help me God.

(Signature) Jack L. Partridge  
801 Union Center, Wichita, Kansas 67202  
(Address)

SUBSCRIBED AND SWORN TO before me this 8th day of July, 1977

Sandra Richman  
Sandra Richman Notary Public.

My commission expires July 21, 1979

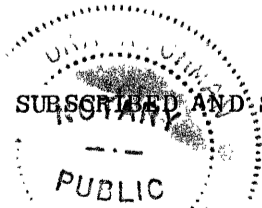

OPERATOR: White Eagle Petroleum Company  
 CONTRACTOR: Abercrombie Drilling, Inc.  
 WELL NAME: Huff "F" #1  
 LOCATION: C NE NW Section 11-1S-26W  
 Decatur County, Kansas  
 SPUD DATE: June 11, 1977  
 COMPLETION DATE: June 14, 1977

0	110	Clay & rock
110	1550	Shale
1550	1611	Sand
	1611	Rotary Total Depth
		Lost returns, could not regain circulation

Spud hole at 11:15 a.m., June 11, 1977. Drilled 231' of 12-1/4" hole. Ran 220.06' of 8-5/8" casing set at 230.06'. Cemented with 175 sacks of 60-40 posmix, 2% gel, 3% CaCl. Cement did circulate. Plug was down at 4:15 p.m., June 11, 1977.

Lost circulation, unable to drill ahead, June 14, 1977. Bridged hole at 210' with wooden plug, 1/2 sack Hulls and 50 lbs. dry cement on top of plug. Filled hole with 3 yards of Redi-Mix cement poured into hole 1 yard at a time. Let cement harden and then poured another quantity of cement at a later date. In this manner a solid plug of cement was set from 210' to the surface.

STATE OF KANSAS )  
 ) ss  
 COUNTY OF SEDGWICK )

RECEIVED  
 STATE CONSERVATION COMMISSION  
 7-11-1977  
 JUL 11 1977  
 CONSERVATION DIVISION  
 Wichita, Kansas

Jack L. Partridge, Assistant Secretary-Treasurer of Abercrombie Drilling, Inc., does hereby state that the above and foregoing is a true and correct copy of the log of the Huff "F" #1, C NE NW Section 11-1S-26W, Decatur County, Kansas.


ABERCROMBIE DRILLING, INC.

BY Jack L. Partridge  
 Jack L. Partridge  
 Assistant Secretary-Treasurer

Subscribed and sworn to before me, a Notary Public, in and for the county and state aforesaid, as of this 8th day of July, 1977.

Sandra Richman  
 Sandra Richman, Notary Public

My commission expires July 21, 1979.

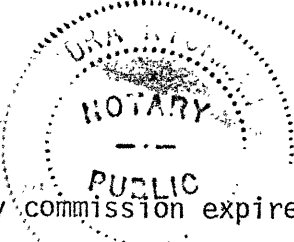

Notary Public Seal: A circular seal with 'NOTARY PUBLIC' in the center and 'DWA' at the top.