


15-039-20501-00-00

STATE OF KANSAS
STATE CORPORATION COMMISSION

WELL PLUGGING RECORD

Give All Information Completely
Make Required Affidavit
Mail or Deliver Report to
Conservation Division
State Corporation Comm.
245 North Water
Wichita, KS 67202

Decatur County, Sec. 11 Twp. 1-S Rge. 26-W E/W
Location as "NE/CNW $\frac{1}{4}$ SW $\frac{1}{4}$ " or footage from lines
C SW $\frac{1}{4}$ SW $\frac{1}{4}$
Lease Owner E. J. Ackman
Lease Name Cozad Well No. #1
Office Address Colorado State Bank Bldg.
Suite 1910, Denver, Colorado 80203
Character of Well (Completed as Oil, Gas or Dry Hole)

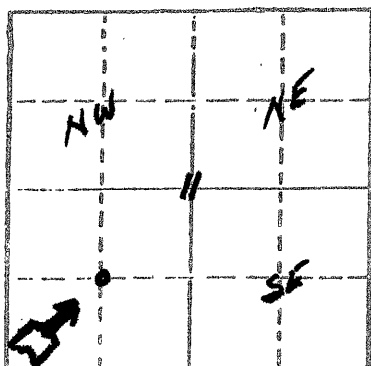

Locate well correctly on above
Section Plot

Dry Hole
Date Well completed May 15, 19 80
Application for plugging filed May 14, 19 80
Application for plugging approved May 14, 19 80
Plugging commenced May 15, 19 80
Plugging completed May 15, 19 80

Reason for abandonment of well or producing formation

Dry Hole
If a producing well is abandoned, date of last production
N/A 19

Was permission obtained from the Conservation Division or
its agents before plugging was commenced? Yes

Name of Conservation Agent who supervised plugging of this well Balthazor (Palco)
Producing formation N/A Depth to top X Bottom X Total Depth of Well 3511'
Show depth and thickness of all water, oil and gas formations.

OIL, GAS OR WATER RECORDS

CASING RECORD

FORMATION	CONTENT	FROM	TO	SIZE	PUT IN	PULLED OUT
Surface	XXXX (W)	0	129	8 5/8"	129	0

Describe in detail the manner in which the well was plugged, indicating where the mud fluid
was placed and the method or methods used in introducing it into the hold. If cement or other
plugs were used, state the character of same and depth placed, from 40' feet to
800' feet for each plug set. Plug set 800'/60sx Plug 130'/30sx Plug 40'/10sx
Filled Rat hole/5sx All cement 50/50% pos-mix/6% Gel


RECEIVED
STATE CORPORATION COMMISSION
5-19-1980
MAY 19 1980

(If additional description is necessary, use BACK of this form)
Name of Plugging Contractor Sun Cementing Co.

STATE OF Kansas COUNTY OF Decatur, ss.
James A. Betts co-operator (employee of owner) or (owner or operator)
of the above-described well, being first duly sworn on oath, says: That I have knowledge of
the facts, and matters herein contained and the log of the above-described well
as filed and that the same are true and correct. So help me God.

(Signature) *James A. Betts*
601 North Penn Ave. Oberlin, Kansas
(Address)

SUBSCRIBED AND SWORN TO before me this 17th day of May, 1980

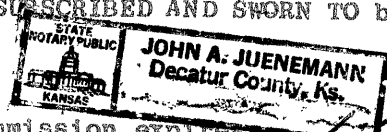

John A. Juennemann
Notary Public.

My commission expires 2-25-83