


Give All Information Completely
Make Required Affidavit
Mail or Deliver Report to:
Conservation Division
State Corporation Commission
211 No. Broadway
Wichita, Kansas

WELL PLUGGING RECORD

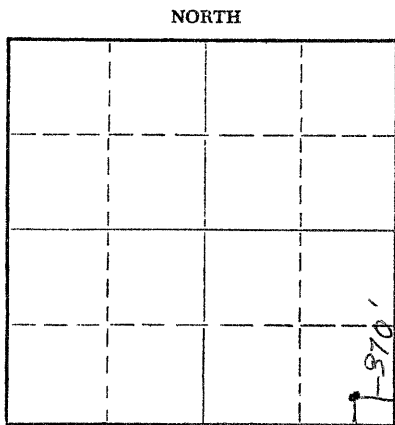

Locate well correctly on above Section Plat

Decatur County, Sec. 19 Twp. 1 Rge. (E) 26 (W)
Location as "NE/CNW/SW" or footage from lines se se
Lease Owner Lester Chambers
Lease Name Wiggins Well No. 1
Office Address Oberlin, Kansas
Character of Well (completed as Oil, Gas or Dry Hole) dry hole
Date well completed Feb 14 19 78
Application for plugging filed Feb 14 (phone) 19 78
Application for plugging approved Feb 14 (phone) 19 78
Plugging commenced Feb 14 19 78
Plugging completed Feb 14 19 78
Reason for abandonment of well or producing formation dry hole

If a producing well is abandoned, date of last production 19
Was permission obtained from the Conservation Division or its agents before plugging was commenced? yes

Name of Conservation Agent who supervised plugging of this well Gilbert Balthazor
Producing formation none Depth to top _____ Bottom _____ Total Depth of Well 3622 Feet
Show depth and thickness of all water, oil and gas formations.

OIL, GAS OR WATER RECORDS

CASING RECORD

| FORMATION | CONTENT | FROM | TO | SIZE | PUT IN | PULLED OUT |
|-----------|---------|------|----|-------|--------|------------|
| | | | | 8 5/8 | 203 | 0 |
| | | | | | | |
| | | | | | | |
| | | | | | | |
| | | | | | | |
| | | | | | | |

Describe in detail the manner in which the well was plugged, indicating where the mud fluid was placed and the method or methods used in introducing it into the hole. If cement or other plugs were used, state the character of same and depth placed, from see below feet to _____ feet for each plug set.

70 sacks 50/50 Pozmix 6% Gel displaced by Halliburton at 1500 ft.
20 sacks do at 200 ft.
10 sacks do at 40 ft.

RECEIVED
STATE CORPORATION COMMISSION

MAR 06 1978 3-6-78

CONSERVATION DIVISION
Wichita, Kansas

(If additional description is necessary, use BACK of this sheet)
Name of Plugging Contractor Halliburton Services
Address Oberlin, Kansas

STATE OF Kansas, COUNTY OF Decatur, ss. Lester Chambers (~~owner~~) or (owner or operator) of the above-described well, being first duly sworn on oath, says: That I have knowledge of the facts, statements, and matters herein contained and the log of the above-described well as filed and that the same are true and correct. So help me God.

(Signature) Lester Chambers
310 East Ash, Oberlin, Kansas 67749
(Address)

SUBSCRIBED AND SWORN TO before me this 3rd day of March, 1978

My commission expires Feb 12 - 1981
[Signature] Notary Public.

15-039-20408-00-00

DRILLERS LOG

STOEPPELWERTH DRILLING, INC.
MCCOOK, NEBRASKA

WELL: Chambers #1 Wiggins COMMENCED DRILLING: February 7, 1978

LOCATION: SE SE 19-1-26 COMPLETED DRILLING: February 14, 1978
Decatur County, Kansas PLUGGED: February 14, 1978

SURFACE CASING: 8 5/8" @ 210' with 150 sx. 50-50 pozmix

| <u>FOOTAGE</u> | <u>FORMATION</u> |
|----------------|------------------------------|
| 0- 185 | Surface clay & sand |
| 185- 1125 | Shale |
| 1125- 1970 | Sand & shale |
| 1970- 2000 | Anhydrite |
| 2000- 2900 | Sand & shale w/ lime streaks |
| 2900- TD | Lime & shale |

RECEIVED
STATE CORPORATION COMMISSION
MAR 06 1978
3-6-78
CONSERVATION DIVISION
Wichita, Kansas

I hereby certify that the above and foregoing is a true and accurate report of the drilling of the well described.

DATE: February 21, 1978

[Signature]
G. P. Stoeppelwerth, II

State of Nebraska
County of Red Willow

Subscribed and sworn before me, a Notary Public, this 21st day of February, 1978

[Signature]
Robert J. Lewis

