


STATE OF KANSAS
STATE CORPORATION COMMISSION

Give All Information Completely
Make Required Affidavit
Mail or Deliver Report to:
Conservation Division
State Corporation Commission
212 No. Market
Wichita, Kansas 67202

15-039-20207-00-00 Form CP-4
WELL PLUGGING RECORD

Decatur County, Sec. 5 Twp. 1 Rge. 26 (W) X

Location as "NE/CNW/SW" or footage from lines
Lease Owner Platte Valley Oil Co., Inc.
Lease Name Daffer Well No. 3
Office Address 214 Hillcrest Center Bldg. Ralston, Nebr.
Character of Well (completed as Oil, Gas or Dry Hole) D & A
Date well completed 20 April 1971 19
Application for plugging filed 20 April 1971 19
Application for plugging approved 20 April 1971 19
Plugging commenced 23 April 1971 19
Plugging completed 20 April 1971 19
Reason for abandonment of well or producing formation D & A

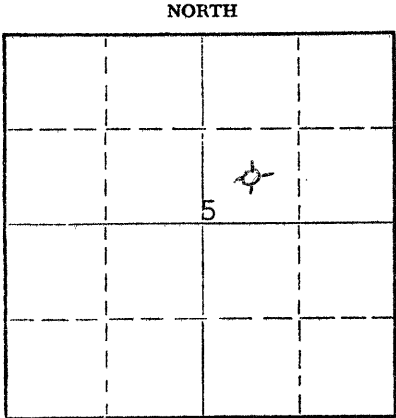

Locate well correctly on above Section Plat

If a producing well is abandoned, date of last production _____ 19
Was permission obtained from the Conservation Division or its agents before plugging was commenced? _____

Name of Conservation Agent who supervised plugging of this well W. L. Nichols, Box 157, Morland, Kansas
Producing formation _____ Depth to top _____ Bottom _____ Total Depth of Well 3610 Feet
Show depth and thickness of all water, oil and gas formations.

OIL, GAS OR WATER RECORDS

CASING RECORD

FORMATION	CONTENT	FROM	TO	SIZE	PUT IN	PULLED OUT
Surface casing		0	262	8 5/8	X	None

Describe in detail the manner in which the well was plugged, indicating where the mud fluid was placed and the method or methods used in introducing it into the hole. If cement or other plugs were used, state the character of same and depth placed, from _____ feet to _____ feet for each plug set.

100 sacks at 1000 feet
25 sacks at 275 feet
10 sacks at 40 feet

RECEIVED
STATE CORPORATION COMMISSION
JUN 16 1971
CONSERVATION DIVISION
Wichita, Kansas
June 16, 1971

(If additional description is necessary, use BACK of this sheet)
Name of Plugging Contractor Co. Tools and Halliburton
Address 214 Hillcrest Center Bldg. Ralston, Nebraska 68127

STATE OF Nebraska, COUNTY OF Douglas, ss.
Joseph Marx (employee of owner) or (owner or operator) of the above-described well, being first duly sworn on oath, says: That I have knowledge of the facts, statements, and matters herein contained and the log of the above-described well as filed and that the same are true and correct. So help me God.

(Signature) Joseph Marx
214 Hillcrest Center Bldg., Ralston
(Address) _____, _____, Nebraska


SUBSCRIBED AND SWORN TO before me this 14th day of June, 1971

My commission expires 9 August 1971
John E. Langbran
Notary Public.

PLATTE VALLEY OIL COMPANY, INC.

(A NEBRASKA CORPORATION)

Phone 331-4927 — 214 Hillcrest Center Building
RALSTON, NEBRASKA 68127

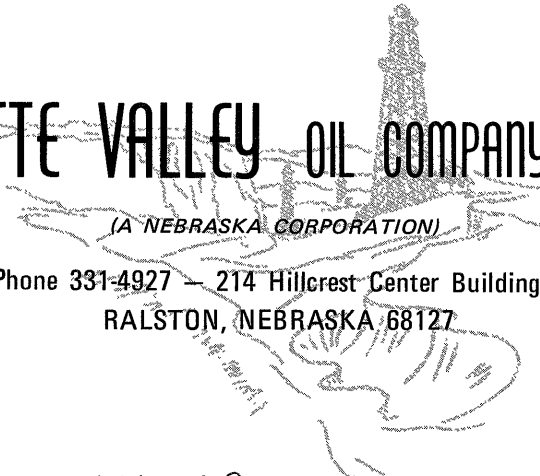

6 May 1971

15-039-20207-00-00

State Corporation Commission
Conservation Division
212 North Market
Wichita, Kansas 67202

Re: Daffer # 3
SW/NE Sec. 5, T1S, R26W
Decatur County, Kansas

WELL PLUGGING RECORD

- 100 sacks at 1000 feet
- 25 sacks at 275 feet
- 10 sacks at 40 feet

Sincerely,

John Loughran
John Loughran

RECEIVED
STATE CORPORATION COMMISSION
MAY 10 1971
CONSERVATION DIVISION
Wichita, Kansas
5-10-1971