


15-039-20333-00-00

STATE OF KANSAS
STATE CORPORATION COMMISSION
CONSERVATION DIVISION
P. O. BOX 17027
WICHITA, KANSAS 67217

FORM CP-4

WELL PLUGGING RECORD

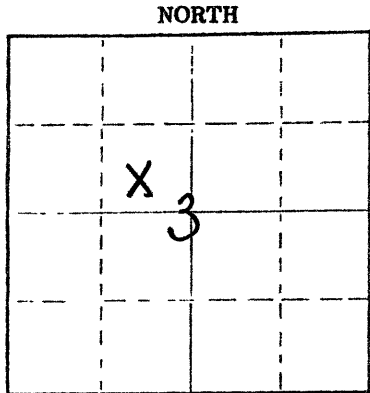

Locate well correctly on above Section Plat

Decatur County. Sec. 3 Twp. 1S Rge. XXB 26 (W)
Location as "NE/CNW/SW" or footage from lines. C SE NW
Lease Owner W. W. Sauvage, Inc.
Lease Name HUFF "C" Well No. 1
Office Address 404 N. Penn Oberlin, KS 67749
Character of Well (completed as Oil, Gas or Dry Hole) Dry Hole
Date well completed May 13 1976
Application for plugging filed (verbally) May 13 1976
Application for plugging approved (verbally) May 13 1976
Plugging commenced May 13 1976
Plugging completed May 13 1976
Reason for abandonment of well or producing formation No commercial quantity of gas or oil encountered.
If a producing well is abandoned, date of last production 19
Was permission obtained from the Conservation Division or its agents before plugging was commenced? Yes

Name of Conservation Agent who supervised plugging of this well Gilbert Balthozer
Producing formation _____ Depth to top _____ Bottom _____ Total Depth of Well 3520'
Show depth and thickness of all water, oil and gas formations.

OIL, GAS OR WATER RECORDS

CASING RECORD

FORMATION	CONTENT	FROM	TO	SIZE	PUT IN	PULLED OUT
				8 5/8"	207 K.B.	None

Describe in detail the manner in which the well was plugged, indicating where the mud fluid was placed and the method or methods used in introducing it into the hole. If cement or other plugs were used, state the character of same and depth placed, from _____ feet to _____ feet for each plug set.

1st Plug set @ 1200' with 75 sacks
2nd Plug set @ 200' with 20 sacks
3rd Plug set @ 40' with 10 sacks
Plug was down @ 4:00 a.m. May 13, 1976
State Pluggger: Gilbert Balthazor

RECEIVED
STATE CORPORATION COMMISSION
5-20-1976
MAY 20 1976

Name of Plugging Contractor Abercrombie Drilling, Inc.
Address 801 Union Center, Wichita, Kansas 67202


STATE OF KANSAS COUNTY OF SEDGWICK ss.
Jerry A. Langrehr-Exec. V. P. (employee of owner) or (owner or operator) of the above-described

well, being first duly sworn on oath, says: That I have knowledge of the facts, statements, and matters herein contained and the log of the above-described well as filed and that the same are true and correct. So help me God.

(Signature) Jerry A. Langrehr
801 Union Center, Wichita, KS 67202
(Address)

SUBSCRIBED AND SWORN TO before me this 19th day of May, 1976

My commission expires February 18, 1980
Diane Steincamp
Diane Steincamp Notary Public.

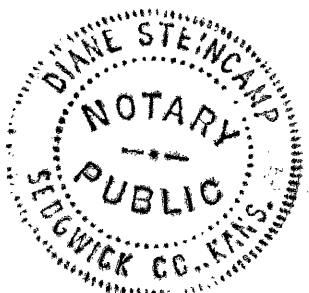

CONTRACTOR'S WELL LOG

15-039-20333-00-00

OPERATOR: W. W. Sauvage, Inc.
 CONTRACTOR: Abercrombie Drilling, Inc.
 WELL NAME: HUFF "C" #1
 LOCATION: C SE NW Section 3-1S-26W
 Decatur County, Kansas
 SPUD DATE: May 6, 1976
 COMPLETION DATE: May 13, 1976

0	175	Clay & Sand
175	207	Shale
207	943	Shale & Sand
943	1010	Shale
1010	1225	Sand
1225	1610	Shale
1610	1755	Sand
1755	1982	Shale
1982	2009	Anhydrite
2009	2518	Shale
2518	3070	Shale & Lime
3070	3324	Lime & Shale
3324	3520	Lime
	3520	Rotary Total Depth

Drilled 207' of 12 1/4" hole. Ran 5 joints 8 5/8" 28# casing, Set @207' K.B. with 160 sx. 60/40 Posmix, 2% gel, 3% ca. cl. Cement did Circulate. Plug was down @ 7:00 p.m. May 6, 1976.

PLUGGED AND ABANDONED: 1st plug was Set @1200' with 75 sx. cement. 2nd Plug was set @ 200' with 20 sx. cement. 3rd Plug was Set @ 40' with 10 sacks cement. State Plugger: Gilbert Balthazor Plug was down @ 4:00 a.m. May 13, 1976.

SAMPLE TOPS:

Anhydrite 1983'
 B/Anhydrite 2009'

5-20-1976
 20 ESTC

STATE OF KANSAS)
 COUNTY OF SEDGWICK) SS

Jerry A. Langrehr, Executive Vice President of Abercrombie Drilling, Inc. does hereby state that the above and foregoing is a true and correct copy of the log of the HUFF "C" #1 C SE NW Section 3-1S-26W Decatur County, Kansas.

ABERCROMBIE DRILLING, INC.

By: Jerry A. Langrehr
 Jerry A. Langrehr, Exec. V.P.

Subscribed and sworn to before me, a Notary Public, in and for the aforesaid county and state as of this 19th day of May, 1976.

Diane Steincamp
 Diane Steincamp

My Commission Expires: February 18, 1980

