

15-039-20321-00-00

STATE OF KANSAS  
STATE CORPORATION COMMISSION

Form CP-4


Give All Information Completely  
Make Required Affidavit  
Mail or Deliver Report to:  
Conservation Division  
State Corporation Commission

WELL PLUGGING RECORD

P. O. Box 17027  
Wichita, Kansas 67217  
NORTH

Decatur County, Sec. 3 Twp. 1S Rge. 26 (W) SE SE SW

Location as "NE/CNW/SW" or footage from lines  
Lease Owner: Sauvage, Inc.  
Lease Name: KITZER  
Office Address: P. O. Box 132, Oberlin, Kansas 67749 Well No. #4  
Character of Well (completed as Oil, Gas or Dry Hole): Dry Hole  
Date well completed: November 1, 19 75  
Application for plugging filed (verbally): November 1, 19 75  
Application for plugging approved (verbally): November 1, 19 75  
Plugging commenced: November 1, 19 75  
Plugging completed: November 1, 19 75  
Reason for abandonment of well or producing formation: No commercial quantity of oil or gas encountered.  
If a producing well is abandoned, date of last production: 19  
Was permission obtained from the Conservation Division or its agents before plugging was commenced? Yes

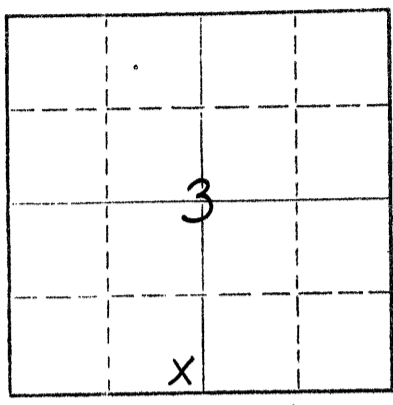

Locate well correctly on above Section Plat

Name of Conservation Agent who supervised plugging of this well: Gilbert Balthazor  
Producing formation: Depth to top: Bottom: Total Depth of Well: 3629' Feet  
Show depth and thickness of all water, oil and gas formations.

OIL, GAS OR WATER RECORDS CASING RECORD

FORMATION	CONTENT	FROM	TO	SIZE	PUT IN	PULLED OUT
				8 5/8"	212' K.B.	none

Describe in detail the manner in which the well was plugged, indicating where the mud fluid was placed and the method or methods used in introducing it into the hole. If cement or other plugs were used, state the character of same and depth placed, from feet to feet for each plug set.

1st Plug was set @ 1000' with 70 sx.  
2nd Plug was set @ 200' with 20 sx.  
3rd Plug was set @ 40' with 10 sx.  
Plug was down @ 6:00 a.m. November 1, 1975

RECEIVED  
STATE CORPORATION COMMISSION  
11-7-1975  
NOV 7 1975  
CONSERVATION DIVISION  
Wichita, Kansas

(If additional description is necessary, use BACK of this sheet)  
Name of Plugging Contractor: Abercrombie Drilling, Inc.  
Address: 801 Union Center, Wichita, Kansas 67202

STATE OF KANSAS, COUNTY OF SEDGWICK, ss.  
Jerry A. Langrehr-Exec. V.P. (employee of owner) or (owner or operator) of the above-described well, being first duly sworn on oath, says: That I have knowledge of the facts, statements, and matters herein contained and the log of the above-described well as filed and that the same are true and correct. So help me God.

(Signature) Jerry A. Langrehr  
801 Union Center, Wichita, Kansas 67202 (Address)

Sandra Russell  
NOTARY PUBLIC  
My commission expires July 21, 1979

SUBSCRIBED AND SWORN to before me this 6th day of November, 19 75  
Sandra Russell Notary Public.

CONTRACTOR'S WELL LOG

OPERATOR:	Sauvage, Inc.
CONTRACTOR:	Abercrombie Drilling, Inc.
WELL NAME:	KILZER #4
LOCATION:	SE SE SW Section 3-1S-26W Decatur County, Kansas
GEOLOGIST:	Charles Johnson
SPUD DATE:	October 25, 1975
COMPLETION DATE:	November 1, 1975

0	60	Clay
60	118	Sand
118	126	Flint
126	460	Shale
460	1275	Shale and Sand streaks
1275	1350	Shale
1350	1430	Sand
1430	1645	Shale
1645	1755	Sand
1755	1975	Shale
1975	2002	Anhydrite
2002	2090	Shale
2090	3241	Lime & Shale
3241	3629	Lime
	3629	Rotary Total Depth

RECORDED  
 11-7-1975  
 NOTARY PUBLIC

Drilled 215' of 12 1/4" hole. Set @ 212' K.B. 8 5/8" casing, with 160 sx. HA5 cement. Plug was down @ 11:30 p.m. October 25, 1975.

Plugged and Abandoned: 1st Plug was set @ 1000' with 70 sx. cement; 2nd Plug was set @ 200' with 20 sx. cement; 3rd Plug was set @ 40' with 10 sx. cement. State Plugger: Gilbert Balthazor Plug was down @ 6:00 a.m. November 1, 1975.

SAMPLE TOPS:	ELEVATION:
Anhydrite 1975'	2494' K.B.
B/Anhydrite 2002'	2493' D.F.
	2487' G.L.

STATE OF KANSAS )  
 ) SS  
 COUNTY OF SEDGWICK )

Jerry A. Langrehr, Executive Vice President of Abercrombie Drilling, Inc., does hereby state that the above and foregoing is a true and correct copy of the log of the KILZER #4, SE SE SW Section 3-1S-26W, Decatur County, Kansas.

ABERCROMBIE DRILLING, INC.

By: Jerry A. Langrehr  
 Jerry A. Langrehr-Exec. V.P.

Subscribed and sworn to before me, a Notary Public, in and for the aforesaid county and state as of this 6th day of November, 1975.

Sandra Russell  
 Sandra Russell-Notary Public

My Commission Expires: July 21, 1979

