

15-147-00816-00-00


STATE OF KANSAS
STATE CORPORATION COMMISSION

Give All Information Completely
Make Required Affidavit
Mail or Deliver Report to:
Conservation Division
State Corporation Commission
800 Bittling Building
Wichita, Kansas

WELL PLUGGING RECORD

Phillips County. Sec. 36 Twp. 1 Rge. 19 (W)
Location as "NE/CNW¼SW¼" or footage from lines NE NW SE
Lease Owner Cooperative Refinery Association
Lease Name Jackson "A" Well No. 1
Office Address Box 765, Great Bend, Kansas
Character of Well (completed as Oil, Gas or Dry Hole) Oil
Date well completed November 1950 19
Application for plugging filed June 26, 1951 19
Application for plugging approved June 27, 1951 19
Plugging commenced July 2, 1951 19
Plugging completed July 9, 1951 19
Reason for abandonment of well or producing formation Insufficient Production

NORTH

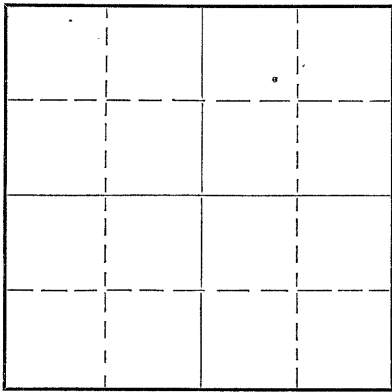

Locate well correctly on above
Section Plat

If a producing well is abandoned, date of last production June 25, 1951 19
Was permission obtained from the Conservation Division or its agents before plugging was com-
menced? Yes

Name of Conservation Agent who supervised plugging of this well Eldon Petty
Producing formation Lansing-Kansas City Depth to top Bottom Total Depth of Well 3536 Feet
Show depth and thickness of all water, oil and gas formations.

OIL, GAS OR WATER RECORDS


CASING RECORD

Formation	Content	From	To	Size	Put In	Pulled Out
				5 1/2"		1718'

Describe in detail the manner in which the well was plugged, indicating where the mud fluid was placed and the method or methods used in introducing it into the hole. If cement or other plugs were used, state the character of same and depth placed, from feet to feet for each plug set.

29 Sacks of Cement
14 Sacks of Aquagel
3 Sacks of Hulls

4 Sacks cement 3400'
14 Sacks aquagel 2200'
3 Sacks Hulls 2200'
15 Sacks Cement 200'
10 Sacks Cement 35'

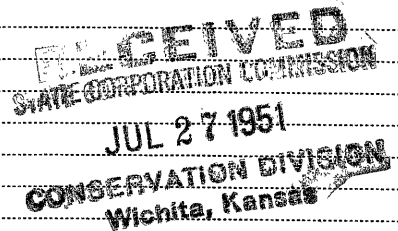

(If additional description is necessary, use BACK of this sheet)

Correspondence regarding this well should be addressed to Cooperative Refinery Association
Address Box 765, Great Bend, Kansas

STATE OF KANSAS, COUNTY OF BARTON, ss.
JOHN H. NATION (employee of owner) or (owner or operator) of the above-described well,
being first duly sworn on oath, says: That I have knowledge of the facts, statements, and matters herein contained and the log of the above-described well as filed and that the same are true and correct. So help me God.

(Signature) John H. Nation Supt.
Great Bend, Kansas
(Address)

SUBSCRIBED AND SWORN TO before me this 26th day of July, 19 51
Arthur J. Robinson Notary Public.

My commission expires Feb. 14, 1955

PLUGGING
FILE SEC 36-1-196
BOOK PAGE 90 LINE 44

15-147-00816-00-00

COMPANY: C.R.A. SEC: 36 T. 1 R. 19W
 FARM: JACKSON "A" NO. 1 LOCATION: NE NW SE
 COM: 10-25-50 COMP: 11-19-50 COUNTY: Phillips
 CONTRACTOR: C.R.A. tools STATE: Kansas
 CASING: 8-5/8" @ 218' w/175 sks. ELEVATION: 2230 D.F.
 5 1/2" @ 3534' w/225 sks.

Figures indicate Bottom of Formation

		GEOLOGICAL TOPS D.F.	
shale and shells	110	Heebner shale	3364
sand	195	Leavenworth Lansing	3367
shale and shells	217	Synderville shale	3370
blue shale	660	1st Lansing (Zone 1)	3390
shale and shells	1305	Douglas shale	3401
lime	1440	Zone 2	3407
shale and shells	1801	Zone 3	3440
anhydrite	1829	Zone 4	3458
shale and shells	2085	Zone 5	3473
lime and shale	2595	Zone 6	3481
lime	2855	Zone 7	3496
lime and shale	3070		
lime	3398		
lime and shale	3425		
lime	3540		

R.T.D. 3540 = 3536 D.F.

PLUGGING
 FILE SEC 36 T. 1 R. 19W
 BOOK PAGE 90 LINE 44

RECEIVED
 STATE DEPARTMENT OF REVENUE
 AUG 17 1951
 CONSERVATION DIVISION
 Topeka, Kansas

- PRODUCTION
- CRUDE PURCHASING
- EXPLORATION

FIELD PURCHASE ORDER 15-147-00816-00-00

COOPERATIVE REFINERY ASSOCIATION

Great Bend, Kas.

Box 765
(INVOICE ADDRESS)

Date 7-18-51
(Issued)

To State Corp. Comm. Cons. Div.
(Vendor)
Address 800 Betting Bldg. Wichita, Kas. Please Furnish Us Via

QUAN.	ARTICLE	PRICE
	Plugging Jackson A #1	25 00
	PLUGGING FILE SEC <u>36T L R 196</u> BOOK PAGE <u>90</u> LINE <u>44</u>	
	<i>Jw</i> to <u>90-44</u>	25 00

RECEIVED
JUL 20 1951
COMMISSIONER OF REVENUE
WICHITA, KANSAS

This Purchase Order confirms receipt of your invoice.

INVOICES MUST BE RENDERED IN DUPLICATE TO ASSOCIATION AT ABOVE ADDRESS

Put This Number On Each Invoice
Nº 57912

7-16-51
Employee Certifying Mdse. Rec'd. or Services Rendered - Date

Charge To Jackson A Lease #140 Ordered By Charles Taylor
1141 R-5-7-50-3994-22,500 Sets-A8-D81.