


STATE OF KANSAS
STATE CORPORATION COMMISSION

Give All Information Completely
Make Required Affidavit
Mail or Deliver Report to:
Conservation Division
State Corporation Commission
800 Bitting Building
Wichita, Kansas

15-147-00817-00-00

WELL PLUGGING RECORD

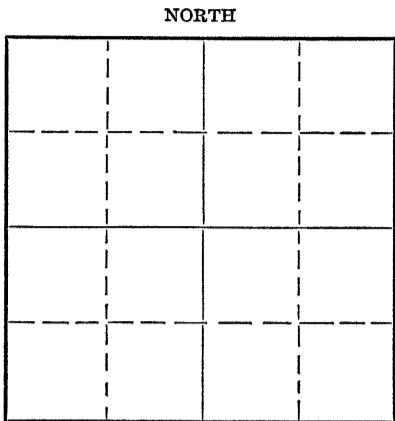

Locate well correctly on above Section Plat

Phillips County. Sec. 36 Twp. 18 Rge. 19 (E) W (W)
Location as "NE/CNW $\frac{1}{4}$ SW $\frac{1}{4}$ " or footage from lines C. NE NE NE
Lease Owner Lawrence & Meltzer Oil Co.
Lease Name Brockett Estate Well No. 1
Office Address Box 414, Great Bend, Kansas
Character of Well (completed as Oil, Gas or Dry Hole) Oil
Date well completed 11/10 19.50
Application for plugging filed 9/28 19.51
Application for plugging approved 9/28 19.51
Plugging commenced 10/34 19.51
Plugging completed 10/19 19.51
Reason for abandonment of well or producing formation Depleted
If a producing well is abandoned, date of last production Sept. 30 19.51
Was permission obtained from the Conservation Division or its agents before plugging was commenced? Yes

Name of Conservation Agent who supervised plugging of this well Eldon Petty
Producing formation Kansas City Depth to top 3388' Bottom 3499' Total Depth of Well 3528 Feet
Show depth and thickness of all water, oil and gas formations.

OIL, GAS OR WATER RECORDS

CASING RECORD

Formation	Content	From	To	Size	Put In	Pulled Out
				5 1/2"		1420'

Describe in detail the manner in which the well was plugged, indicating where the mud fluid was placed and the method or methods used in introducing it into the hole. If cement or other plugs were used, state the character of same and depth placed, from _____ feet to _____ feet for each plug set.

Plugged back w/ crushed rock to 3490'; dumped 4 sacks cement w/ dump bailer. Top of cement 3455'. Mudded hole to 220'; set rock bridge; dumped 15 sacks cement; mudded hole to 35'; set rock bridge, & dumped 10 sacks cement for cap.

RECEIVED
STATE CORPORATION COMMISSION
NOV 19 1951
CONSERVATION DIVISION

(If additional description is necessary, use BACK of this sheet)
Correspondence regarding this well should be addressed to Lawrence & Meltzer Oil Co.
Address Box 414, Great Bend, Kansas

STATE OF ~~Phillips~~ Kansas, COUNTY OF ~~Phillips~~ Barton, ss.
Lawrence & Meltzer Oil Co. (employee of owner) or (owner or operator) of the above-described well,
being first duly sworn on oath, says: That I have knowledge of the facts, statements, and matters herein contained and the log of the above-described well as filed and that the same are true and correct. So help me God,
By Lawrence
(Signature) Lawrence & MELTZER OIL CO.
Box 414, Great Bend, Kansas
(Address)

SUBSCRIBED AND SWORN to before me this 17th day of November, 1951

My commission expires 2/30/53

23-5091-S 8-50-10M

Notary Public.
RECEIVED
STATE CORPORATION COMMISSION
NOV 24 1951
CONSERVATION DIVISION
Wichita, Kansas

30
114
90
22

WELL LOG BUREAU-- KANSAS GEOLOGICAL SOCIETY

508 East Murdock, Wichita, Kansas


15-147-00817-00-00

Company - HONAKER DRILG. CO., INC.
Farm - Brockett Estate No. 1

SEC. 36 T. 1 R. 19W
NE NE NE

Total Depth. 3528
Comm. 11-1-50 Comp. 12-27-50
Shot or Treated.
Contractor. Honaker Drilg. Co., Inc.
Issued. 8-25-51

County. Phillips
KANSAS

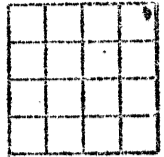

CASING:

8 5/8" cem w/150 sxs. Ran 8 joints.
5 1/2" 3527' cem w/200 sxs.

Elevation. 2214

Production. 103 bbls.

Figures Indicate Bottom of Formations.

top soil, rock	20
shale, sand	120
sand	160
shale, shells	222
shale	500
shale, shells	600
sand	640
shale	1080
sand	1260
shale, shells	1445
sand, shale	1550
shale, red bed	1790
anhydrite	1815
shale, shells	1845
shale	1920
broken lime, shale	2000
lime, shale	2465
shale	2665
shale, lime	3060
lime	3515
lime, shale	3528
Total depth	

Scout tops:	
Anhydrite	1824
Silt Stone	3279
Heebner	3360
Lansing	3388

LANSING
36 T. 1 R. 19W
118