


Give All Information Completely
Make Required Affidavit
Mail or Deliver Report to:
Conservation Division
State Corporation Commission
211 No. Broadway
Wichita, Kansas

NORTH

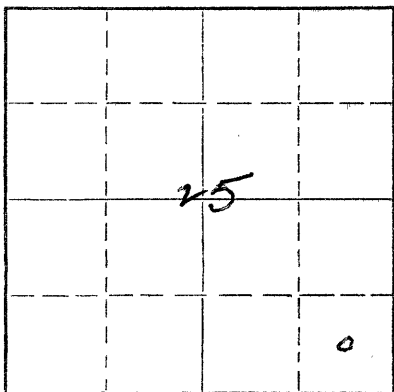

Locate well correctly on above
Section Plat

Phillips County. Sec. 25 Twp. 1 Rge. 19 (E) W (W)
Location as "NE/CNW&SW&" or footage from lines C-SE-SE
Lease Owner Feldt-Maytag And Company
Lease Name Mc Kenzie Well No. 1
Office Address Colorado Springs, Colo.
Character of Well (completed as Oil, Gas or Dry Hole) Oil
Date well completed October 3 1960
Application for plugging filed _____ 19____
Application for plugging approved October 12 1962
Plugging commenced Oct. 19 1962
Plugging completed Oct. 23 1962
Reason for abandonment of well or producing formation Depleted

If a producing well is abandoned, date of last production January 1961
Was permission obtained from the Conservation Division or its agents before plugging was commenced? Yes

Name of Conservation Agent who supervised plugging of this well Elden retty
Producing formation Lansing, K-C Depth to top 3408 Bottom 3640 Total Depth of Well 3650 Feet
Show depth and thickness of all water, oil and gas formations.

OIL, GAS OR WATER RECORDS

CASING RECORD

FORMATION	CONTENT	FROM	TO	SIZE	PUT IN	PULLED OUT
Lansing, K-C		0	3650'	4 1/2	3650'	1912'

Describe in detail the manner in which the well was plugged, indicating where the mud fluid was placed and the method or methods used in introducing it into the hole. If cement or other plugs were used, state the character of same and depth placed, from 3650 feet to surface feet for each plug set.

Well had ben pre. at 3442' Sanded up to 3430', Dump 4 sacks of cement Pull pipe up to 550' Circulated with mud, pump 20 sacks of cement to 550'. Pull pipe to 190' pump 20 sacks of cement to 190' pull pipe from hole & put 10 sacks of cement on top plugging complet.

RECEIVED
STATE CORPORATION COMMISSION

NOV 14 1962

CONSERVATION DIVISION
Wichita, Kansas

(If additional description is necessary, use BACK of this sheet)
Name of Plugging Contractor Barnes and Sons Pipe Pulling Co.
Address Russell, Kansas

STATE OF COLORADO, COUNTY OF EL PASO, ss.
C. L. Feldt, a partner, ~~(employee of owner)~~ or (owner or operator) of the above-described well, being first duly sworn on oath, says: That I have knowledge of the facts, statements, and matters herein contained and the log of the above-described well as filed and that the same are true and correct. So help me God.
FELDT-MAYTAG AND COMPANY By: (Signature) C. L. Feldt, Partner

SUBSCRIBED AND SWORN TO before me this 12th day of November, 1962

My commission expires August 11, 1964 Ordece E. Childs Notary Public.

