


STATE OF KANSAS
STATE CORPORATION COMMISSION

Give All Information Completely
Make Required Affidavit
Mail or Deliver Report to:
Conservation Division
State Corporation Commission
800 Biting Building
Wichita, Kansas

13-147-00815-00-00

WELL PLUGGING RECORD

NORTH

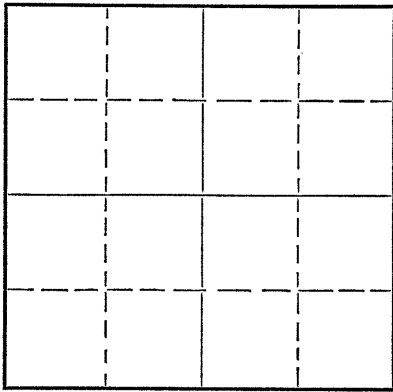

Locate well correctly on above
Section Plat

Phillips County. Sec. 25 Twp. 15 Rge. 19 (E) W (W)
Location as "NE/CNW $\frac{1}{4}$ SW $\frac{1}{4}$ " or footage from lines C. E/2, E/2
Lease Owner Lawrence & Meltzer Oil Co.
Lease Name McKenzie Well No. 1
Office Address Box 414, Great Bend, Kansas
Character of Well (completed as Oil, Gas or Dry Hole) Oil
Date well completed 12/23 19 50
Application for plugging filed 10/2 19 51
Application for plugging approved 10/2 19 51
Plugging commenced 10/8 19 51
Plugging completed 10/13 19 51
Reason for abandonment of well or producing formation Depleted
If a producing well is abandoned, date of last production 9/30 19 51
Was permission obtained from the Conservation Division or its agents before plugging was commenced? Yes

Name of Conservation Agent who supervised plugging of this well Mr. Eldon Petty
Producing formation Kansas City Depth to top 3410' Bottom 3519' Total Depth of Well 3545 Feet
Show depth and thickness of all water, oil and gas formations.

OIL, GAS OR WATER RECORDS

CASING RECORD

Formation	Content	From	To	Size	Put In	Pulled Out
				5 1/2"		1690'

Describe in detail the manner in which the well was plugged, indicating where the mud fluid was placed and the method or methods used in introducing it into the hole. If cement or other plugs were used, state the character of same and depth placed, from _____ feet to _____ feet for each plug set.

Plugged back w/ crushed rock to 3520'; ran 4 sacks cement at 3520' w/ cump bailer; top of cement 3485'; mudded hole to 210'; set rock bridge; dumped 15 sacks cement; top of cement 165'. Filled hole w/ mud to 35'; set rock bridge; dumped 10 sacks for cap

(If additional description is necessary, use BACK of this sheet)
Correspondence regarding this well should be addressed to Lawrence & Meltzer Oil Co.
Address Box 414, Great Bend, Kansas

STATE OF Kansas COUNTY OF Barton, ss.
Lawrence & Meltzer Oil Co. (employee of owner) or (owner or operator) of the above-described well,
being first duly sworn on oath, says: That I have knowledge of the facts, statements, and matters herein contained and the log of the above-described well as filed and that the same are true and correct. So help me God. Lawrence & Meltzer Oil Co.
By *Lawrence*
(Signature) Box 414, Great Bend, Kansas
(Address)
SUBSCRIBED AND SWORN to before me this 17th day of November, 19 51

My commission expires 3/30/53
Notary Public.

23-5091-s 8-50-10M

NOV 24 1951

CONSERVATION DIVISION
Wichita, Kansas

FILE SEC 25 1 19 51
117 14

WELL LOG BUREAU - KANSAS GEOLOGICAL SOCIETY
 508 E. Murdock
 Wichita, Kansas


15-147-00815-00-00

Company - HONAKER DRILG. CO., INC.
 Farm - McKenzie No. 1

SEC. 25 T. 1 R. 19W
 SE SE SE

Total Depth. 3545
 Comm. 12-6-50 Comp. 3-21-51
 Shot or Treated.
 Contractor.
 Issued. 9-22-51

County. Phillips
 KANSAS

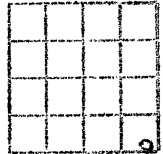

Elevation. 2230

Production. I.P.P. 17 BO & NW

CASING:

8 5/8" 218' cem. w/135 sx
 5 1/2" 3514' cem. w/175 sx

Figures Indicate Bottom of Formations.

soil, rock	60
sand	195
shale	475
shale, sand	600
shale, shells	675
shale, sand	715
shale	930
shale, shells	1105
sand	1255
shale, lime	1520
shale, sand	1540
shells, shale, red rock	1745
red rock, shale	1800
anhydrite	1831
shale	1850
lime, shale	3075
lime	3132
cherty lime	3185
lime	3545
Total Depth	

Scout Tops:
 Heebner 3381
 Lansing 3410

RECEIVED
 KANSAS GEOLOGICAL SOCIETY
 1951

PLUGGING
 FILE SEC. 25 T. 1 R. 19W
 BOOK PAGE 117 LINE 14