

CARD MUST BE TYPED

State of Kansas

CARD MUST BE SIGNED

NOTICE OF INTENTION TO DRILL

(see rules on reverse side)

Starting Date 12 12 86
month day year **3:55**

API Number 15— **039-20,801-00-00**

OPERATOR: License # 8981
Name **Adeco, Inc & Chambers**
Address **310 E. Ash**
City/State/Zip **Oberlin, Kansas 67749**
Contact Person **Lester L. Chambers**
Phone **913-475-3468**

SE NE SE Sec. 14 Twp. 1 S, Rg. 26W X East
1650 Ft. from South Line of Section
330 Ft. from East Line of Section

(Note: Locate well on Section Plat on reverse side)

CONTRACTOR: License # 5302
Name **Red Tiger Drilling Co.**
City/State **Wichita, Kansas 67202**

Nearest lease or unit boundary line 330 feet
County **Decatur**
Lease Name **Cozad "E"** Well # **2**

Well Drilled For: Well Class: Type Equipment:
 Oil SWD Infield Mud Rotary
 Gas Inj Pool Ext. Air Rotary
 OWWO Expl Wildcat Cable

Ground surface elevation 2355 feet MSL
Domestic well within 330 feet: _____ yes X no
Municipal well within one mile: _____ yes X no

If OWWO: old well info as follows:
Operator
Well Name
Comp Date Old Total Depth

Depth to bottom of fresh water 100
Depth to bottom of usable water 1100
Surface pipe by Alternate: 1 _____ 2 X
Surface pipe planned to be set 200
Conductor pipe required **N/A**
Projected Total Depth 3550 feet
Formation **Granite**

I certify that well will comply with K.S.A. 55-101, et seq., plus every other applicable regulatory code or rule specifications.
Date **12-9-86** Signature of Operator or Agent **Raymond A. Angley** Title **Owner**


For KCC Use:
Conductor Pipe Required feet; Minimum Surface Pipe Required **200** feet per Alt. **40**
This Authorization Expires **6-9-87** Approved By **12-9-86**

Must be filed with the K.C.C. five (5) days prior to commencing well
 This card void if drilling not started within six (6) months of date received by K.C.C.

Important procedures to follow:

1. Notify District office before setting surface casing.
2. Set surface casing by circulating cement to the top.
3. File completion forms ACO-1 with K.C.C. within 90 days of well completion, following instructions on ACO-1, side 1, and including copies of wireline logs.
4. Notify District office 48 hours prior to old well workover or re-entry.
5. Prior to filing Intent, prepare a proposed plugging plan in case well is D & A, then obtain approval of plan when calling district office prior to setting surface pipe.
6. Submit plugging report (CP-4) to K. C. C. after plugging is completed.
7. Obtain an approved injection docket number before disposing of salt water.
8. Notify K.C.C. within 10 days when injection commences or terminates.

A Regular Section of Land
1 Mile = 5,280 Ft.

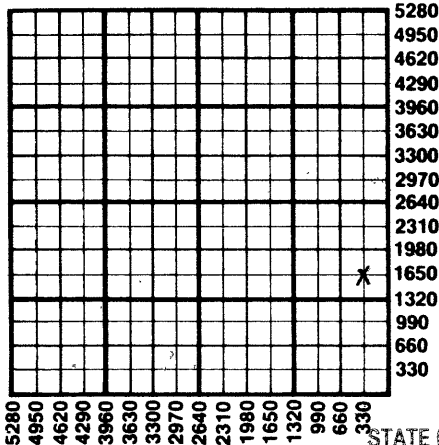

RECEIVED
 STATE CORPORATION COMMISSION
 12-09-1986
 DEC - 9 1986

If an alternate 2 completion, cement in the production pipe from below any usable water to surface within 120 days of spud date.

CONSERVATION DIVISION
 Wichita, Kansas

State Corporation Commission of Kansas
 Conservation Division
 200 Colorado Derby Building
 Wichita, Kansas 67202
 (316) 263-3238