

Notice: Fill out COMPLETELY and return to Conservation Division at the address below within 60 days from plugging date.

KANSAS CORPORATION COMMISSION
OIL & GAS CONSERVATION DIVISION
WELL PLUGGING RECORD
K.A.R. 82-3-117

RECEIVED
MAR 17 2004
KCC WICHITA

Form CP-4
December 2003
Type or Print on this Form
Form must be Signed
All blanks must be Filled

Lease Operator: R.J.M. Oil Company
Address: P.O. Box 265, Claflin, Kansas 67525
Phone: (620) 587-3910 ^{2308 New} ~~3910~~ ^{# Disconnected}
Operator License #: 30458
Type of Well: Oil Docket #: _____
(Oil, Gas D&A, SWD, ENHR, Water Supply Well, Cathodic, Other) (If SWD or ENHR)
The plugging proposal was approved on: February 22nd, 2004 (Date)
by: Virgil Clothier (KCC District Agent's Name)
Is ACO-1 filed? Yes No If not, is well log attached? Yes No
Producing Formation(s): List All (If needed attach another sheet)
_____ Depth to Top: 3273' Bottom: 3273' T.D. 3277'
_____ Depth to Top: _____ Bottom: _____ T.D. _____
_____ Depth to Top: _____ Bottom: _____ T.D. _____

API Number: 15 - 053-20,078 - 00-00
Lease Name: Breford "C"
Well Number: #2 ^{SW NE}
Spot Location (QQQQ): SE ~~SW NE~~
1650 Feet from North / South Section Line
2970 Feet from East / West Section Line
Sec. 3 Twp. 17 S. R. 10 East West
County: Ellsworth
Date Well Completed: July 10th, 1969
Plugging Commenced: March 8th, 2004
Plugging Completed: March 10th, 2004

Show depth and thickness of all water, oil and gas formations.

Oil, Gas or Water Records		Casing Record (Surface Conductor & Production)				
Formation	Content	From	To	Size	Put In	Pulled Out
	Surface	0'	264'	8-5/8"	264'	0'
	Production	0'	3273'	5-1/2"	3273'	0'

Describe in detail the manner in which the well is plugged, indicating where the mud fluid was placed and the method or methods used in introducing it into the hole. If cement or other plugs were used, state the character of same depth placed from (bottom), to (top) for each plug set.

M.I.R.U. Ran bailer to bottom. Spot sand. Got 20 bbls. in hole. Fluid was 500' from surface. Rigged up casing tongs. Spot 5 sxs cement. Rigged up jacks. Cellar started caving in-removed slips-reset jack. Only 2" of stretch. Talked to state-decided to plug with tubing because of casing leak. Rigged down jacks-moved in tubing. Rigged over tubing tongs. Rigged up Log-Tech-perforated @1300',975',575',315'-3 holes per shot. Went in with tubing to 1300'. Pumped 35 sxs-150# hulls; 975'-35 sxs-150 hulls; 575' - 35 sxs-100# hulls; 315' - 35 sxs-100# hulls. Pull out and top off w/100 sxs. Tore down and moved off.

Name of Plugging Contractor: D.S.&W. Well Servicing, Inc. License #: 6901
Address: P.O. Box 231, Claflin, Kansas 67525
Name of Party Responsible for Plugging Fees: R.J.M. Oil Company

State of Kansas County, Barton, ss.

Edward S. Nemnich (Employee of Operator) or (Operator) on above-described well, being first duly sworn on oath, says: That I have knowledge of the facts statements, and matters herein contained, and the log of the above-described well is as filed, and the same are true and correct, so help me God.

(Signature) Edward S. Nemnich
KAREN J. MITCHELL Notary Public - State of Kansas (Address) P.O. Box 231, Claflin, Kansas 67525
My Appt. Expires 4/13/06

SUBSCRIBED and SWORN TO before me this 16th day of March, 20 04
Karen J. Mitchell My Commission Expires: 4/13/06
Notary Public

Notice: Fill out COMPLETELY and return to Conservation Division at the address below within 60 days from plugging date.

KANSAS CORPORATION COMMISSION OIL & GAS CONSERVATION DIVISION WELL PLUGGING RECORD K.A.R. 82-3-117

Form GP-4 December 2003 Type or Print on this Form Form must be Signed All blanks must be Filled

Lease Operator: R.J.M. Oil Company

Address: P.O. Box 265, Claflin, Kansas 67525

Phone: (620) 587-3910 Operator License #: 30458

Type of Well: Oil Docket #: (Oil, Gas D&A, SWD, ENHR, Water Supply Well, Cathodic, Other) (If SWD or ENHR)

The plugging proposal was approved on: February 22nd, 2004 (Date)

by: Virgil Clothier (KCC District Agent's Name)

Is ACO-1 filed? Yes No If not, is well log attached? Yes No

Producing Formation(s): List All (If needed attach another sheet)

Depth to Top: 3273' Bottom: 3273' T.D. 3277'
Depth to Top: Bottom: T.D.
Depth to Top: Bottom: T.D.

API Number: 15-053-20,078-00-00

Lease Name: Breford "C"

Well Number: #2

Spot Location (QQQQ): SE SW NE

1650' Feet from North / South Section Line

2970' Feet from East / West Section Line

Sec. 3 Twp. 17 S. R. 10 East West

County: Ellsworth

Date Well Completed: July 10th, 1969

Plugging Commenced: March 8th, 2004

Plugging Completed: March 10th, 2004

Show depth and thickness of all water, oil and gas formations.

Table with columns: Oil, Gas or Water Records; Casing Record (Surface Conductor & Production). Includes rows for Surface and Production with depth and casing size details.

Describe in detail the manner in which the well is plugged, indicating where the mud fluid was placed and the method or methods used to plug the hole.

M.I.R.U. Ran bailer to bottom, Spot sand. Got 20 bbis. In hole. Fluid was 500' from surface. Rigged up casing tongs. Spot 5 sxs cement. Rigged up jacks.

Cellar started caving in-removed slips-reset jack. Only 2" of stretch. Talked to state-decided to plug with tubing because of casing leak. Rigged down jacks-moved in tubing. Rigged over tubing tongs. Rigged up Log-Tech-perforated @1300'.975'.575'.315'-3 holes per shot. Went in with tubing to 1300'.

Pumped 35 sxs-150# hulls: 975'-35 sxs-150 hulls: 575' - 35 sxs-100# hulls: 315' - 35 sxs-100# hulls. Pull out and top off w/100 sxs. Tore down and moved off.

Name of Plugging Contractor: D.S.&W. Well Servicing, Inc. License #: 6901

Address: P.O. Box 231, Claflin, Kansas 67525

Name of Party Responsible for Plugging Fees: R.J.M. Oil Company

State of Kansas County, Barton, ss.

Edward S. Nemnich (Employee of Operator) or (Operator) on above-described well, being first duly sworn on oath, says: That I have knowledge of the facts statements, and matters herein contained, and the log of the above-described well is as filed, and the same are true and correct, so help me God.

KAREN J. MITCHELL Notary Public - State of Kansas My Appl Expires 4/13/06

(Signature) Edward S. Nemnich

(Address) P.O. Box 231, Claflin, Kansas 67525

SUBSCRIBED and SWORN TO before me this 16th day of March 20 04

(Signature) Karen J. Mitchell Notary Public

My Commission Expires: 4/13/06

Mail to: KCC - Conservation Division, 130 S. Market - Room 207B, Wichita, Kansas 67202

COPY

Barbara Montgomery


Call me and I will discuss Ed Nemick 620-577-3361

KCC LEASE SURVEY PLAT



LEASE _____ COUNTY _____

Section _____ Township _____ Range _____

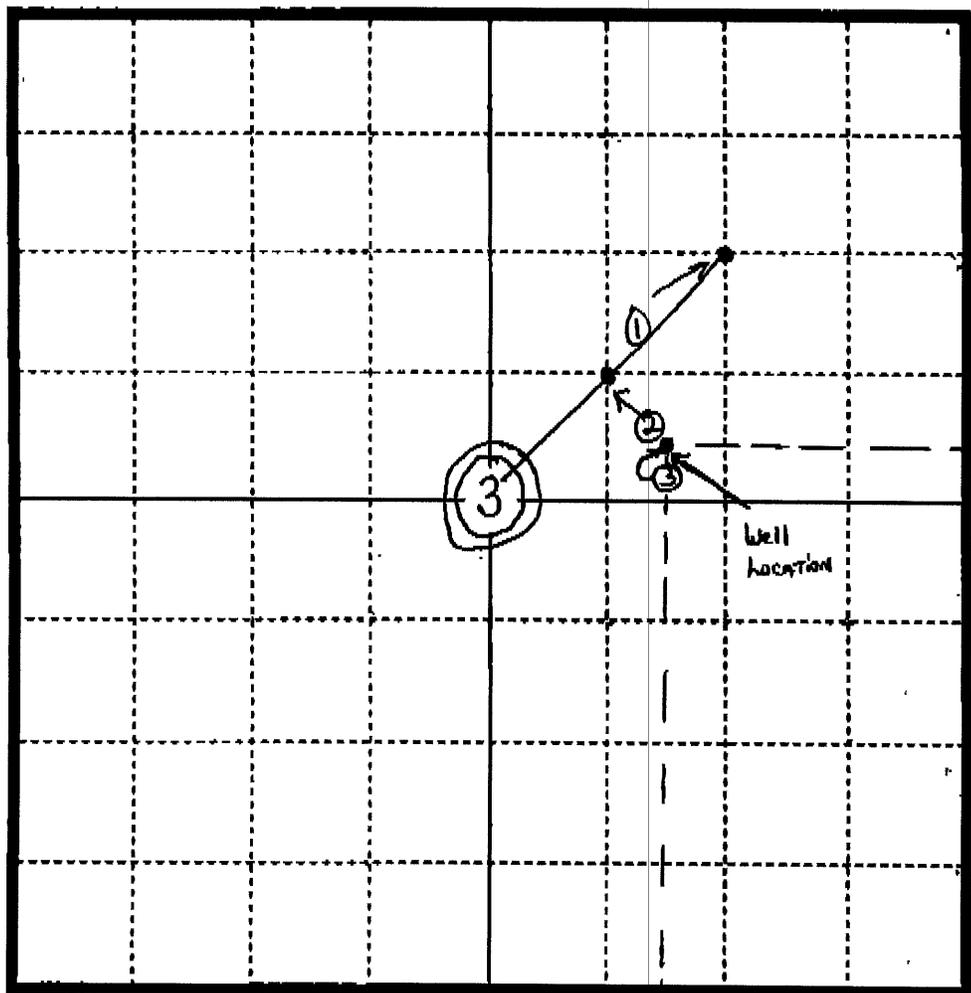

5380
4950
4820
4290
3960
3630
3300
2970
2640
2310
1980
1650
1320
900
600
330

CONSERVATION DIVISION
WICHITA, KS

MAR 26 2004

KANSAS CORPORATION COMMISSION

East

5380 4950 4820 4290 3960 3630 3300 2970 2640 2310 1980 1650 1320 900 600 330

1650 South

Company _____
 Address _____
 City/State _____
 Phone _____ Lin # _____
 KCC Agent _____ Date _____

- Dry Hole
- Oil Well
- Plugged Oil Well
- Plugged SWD
- Gas Well
- Temporary Abandoned
- Abandoned
- Injection Well
- SWD
- Plugged Injection Well
- Water Supply Well