

This form shall be filed in duplicate with the Kansas Corporation Commission, 200 Colorado Derby Building, Wichita, Kansas 67202, within ten days after the completion of the well, regardless of how the well was completed.

Attach separate letter of request if the information is to be held confidential. If confidential, only file one copy. Information on side one will be of public record and side two will then be held confidential.

Circle one: Oil, Gas, Dry, SWD, OWWO, Injection. Type and complete ALL sections. Applications must be filed for dual completion, commingling, SWD and injection, T.A.

Attach wireline logs (i.e. electrical log, sonic log, gamma ray neutron log, etc.). KCC # (316) 263-3238. (Rules 82-2-105 & 82-2-125)

OPERATOR Oxford Exploration Company

API NO. 15-039-20,644-00-00

ADDRESS 1550 Denver Club Building
Denver, CO 80202

COUNTY Decatur

FIELD Brees

**CONTACT PERSON David E. Park, Jr.
PHONE (303) 572-3821

PROD. FORMATION

LEASE E. Huff

PURCHASER

WELL NO. 15-10

ADDRESS

WELL LOCATION 150' W C NW SE

DRILLING Murfin Drilling Company

2130 Ft. from East Line and

CONTRACTOR

1980 Ft. from South Line of

ADDRESS 617 Union Center

the SE 1/4 SEC. 15 TWP. 1S RGE. 26W


Wichita, KS 67202

WELL PLAT

PLUGGING Same

CONTRACTOR

ADDRESS

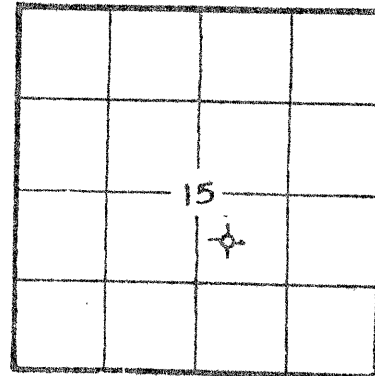

KCC
KGS
(Office Use)
PLG

TOTAL DEPTH 3488 PBT

SPUD DATE 4-7-82 DATE COMPLETED 4-13-82

ELEV: GR 2373 DF KB 2378

DRILLED WITH XXXXXX (ROTARY) XXXXX TOOLS

Amount of surface pipe set and cemented DV Tool Used?

AFFIDAVIT

STATE OF Colorado, COUNTY OF Denver, SS, I,

David E. Park, Jr. OF LAWFUL AGE, BEING FIRST DULY SWORN UPON HIS OATH,

DEPOSES THAT HE IS President (OF) Oxford Exploration Company

OPERATOR OF THE E. Huff LEASE, AND IS DULY AUTHORIZED TO MAKE

THIS AFFIDAVIT FOR AND ON THE BEHALF OF SAID OPERATOR, THAT WELL NO. 15-10 ON

SAID LEASE WAS COMPLETED AS OF THE 13 DAY OF April, 19 82, AND THAT

ALL INFORMATION FURNISHED HEREIN WITH RESPECT TO SAID WELL IS TRUE AND CORRECT.

STATE RECEIVED
CORPORATION DIVISION
05-05-1982
WICHITA, KANSAS

SUBSCRIBED AND SWORN BEFORE ME THIS 22nd DAY OF April, 19 82

(S) David E. Park, Jr.

John H. Miller
NOTARY PUBLIC



EXPIRES: 4-20-85

the person who can be reached by phone regarding any questions concerning this information. Within 45 days of completion, a witnessed initial test by the Commission is required if the well produces more than 25 BOPD or is located in a Basic Order Pool.

SIDE TWO

WELL LOG

Show all important zones of porosity and contents thereof; cored intervals, and all drill-stem tests, including depth interval tested, cushion used, time tool open, flowing and shut-in pressures, and recoveries.

SHOW GEOLOGICAL MARKERS, LOGS RUN, OR OTHER DESCRIPTIVE INFORMATION.

FORMATION DESCRIPTION, CONTENTS, ETC.	TOP	BOTTOM	NAME	DEPTH
Dst #1 3176-3220			Anhydrite	1835
15-39-45-90			Severy	2984
Rec. 10' oil			Topeka	3005
212' OCWM			Deer Creek	3074
355' SOCW			Oread	3111
IHP 1778 IF 145-165 ISIP 651			Toronto	3159
FHP 1727 FF 207-300 FSIP 651			Lansing	3166
			BKC	3372
DST #2 3220-3350			Sand	3450
15-30-45-90			Granite Wash	3470
Rec. 110' SOCM				
245' SOCWM				
630' MW				
IHP 1747 IF 352-383 ISIP 836				
FHP 1747 FF 456-518 FSIP 866				
Dst #3 3155-3175				
30-60-60-90				
Rec. 75' DM				
IHP 1541 IF 490 tool plugged ISIP 1018				
FHP 1462 FF none FSIP 998				

Report of all strings set — surface, intermediate, production, etc. **CASING RECORD** (New) or ~~(Used)~~

Purpose of string	Size hole drilled	Size casing set (in O.D.)	Weight lbs/ft.	Setting depth	Type cement	Sacks	Type and percent additives
Surface	12 1/4"	8 5/8"	20#	122'	60-40 pozmix	125	3% CC

LINER RECORD

PERFORATION RECORD

Top, ft.	Bottom, ft.	Sacks cement	Shots per ft.	Size & type	Depth interval

TUBING RECORD

Size	Setting depth	Packer set at

ACID, FRACTURE, SHOT, CEMENT SQUEEZE RECORD

Amount and kind of material used	Depth interval treated

Date of first production	Producing method (flowing, pumping, gas lift, etc.)	Gravity

RATE OF PRODUCTION PER 24 HOURS	Oil	Gas RELEASED	Water	Gas-oil ratio
		bbis. MCF	%	bbis.

Disposition of gas (vented, used on lease or sold)	Perforations

MAY 1 1983

FROM CONFIDENTIAL

