


15-039-20143-00-00

Give All Information Completely  
Make Required Affidavit  
Mail or Deliver Report to:  
Conservation Division  
State Corporation Commission  
212 No. Market  
Wichita, Kansas 67202

WELL PLUGGING RECORD

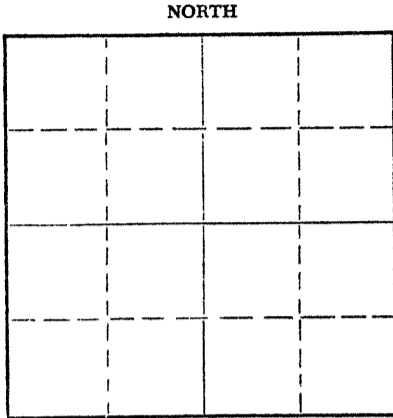

Locate well correctly on above Section Plat

Decatur County. Sec. 20 Twp. 1S Rge. (E) 26 (W)  
Location as "NE/CNW/SW" or footage from lines 440' SNL & 440' EWL NW/4  
Lease Owner Okmar Oil company  
Lease Name Hoover Well No. 1  
Office Address 1130 Wichita Plaza - Wichita, Kansas  
Character of Well (completed as Oil, Gas or Dry Hole) dry  
Date well completed 2-24- 19 70  
Application for plugging filed 2-24 19 70  
Application for plugging approved 2-24 19 70  
Plugging commenced 9:00 AM 2-24 19 70  
Plugging completed 11:00 AM 2-24 19 70  
Reason for abandonment of well or producing formation

If a producing well is abandoned, date of last production 19  
Was permission obtained from the Conservation Division or its agents before plugging was commenced? yes

Name of Conservation Agent who supervised plugging of this well Bill Nicholls - Morland, Kansas  
Producing formation Depth to top Bottom Total Depth of Well 3551 Feet  
Show depth and thickness of all water, oil and gas formations.

OIL, GAS OR WATER RECORDS

CASING RECORD

FORMATION	CONTENT	FROM	TO	SIZE	PUT IN	PULLED OUT
Sand & Shale		0	312	8 5/8	209	0

Describe in detail the manner in which the well was plugged, indicating where the mud fluid was placed and the method or methods used in introducing it into the hole. If cement or other plugs were used, state the character of same and depth placed, from feet to feet for each plug set.

Plugged hole with 100 sx @ 1150' 25 sx @ 310' & bridge to hold Kelly @ 40' w/ 10 sx

RECEIVED  
STATE CORPORATION COMMISSION  
MAR 2 1970  
CONSERVATION DIVISION  
Wichita, Kansas  
03-02-1970

Name of Plugging Contractor B & B Drilling, Inc.  
Address 207 Petroleum Building - Wichita, Kansas

STATE OF Kansas, COUNTY OF Sedgwick, ss.  
Bill Lahar (employee of owner) or (owner or operator) of the above-described well, being first duly sworn on oath, says: That I have knowledge of the facts, statements, and matters herein contained and the log of the above-described well as filed and that the same are true and correct. So help me God.

(Signature) Bill Lahar  
207 Petroleum Building - Wichita, Kansas  
(Address)

SUBSCRIBED AND SWORN TO before me this 27th day of February, 19 70

My commission expires May 31, 1970  
Alma A. Neises Notary Public.

# B & B DRILLING, INC.

548 Petroleum Building

Wichita, Kansas 67202

February 27, 1970

15-039-20143-00-00

## DRILLERS LOG

Re: Hoover #1  
440' SNL & 440' EWL NW/4  
Decatur County, Kansas

OPERATOR: Okmar Oil Company  
CONTRACTOR: B & B Drilling, Inc.  
COMMENCED: February 17, 1970  
COMPLETED: February 24, 1970  
TOTAL DEPTH: 3551'

0	312	Sand & Shale	
312	1160	Shale & Sand	
1160	1777	Shale & Sand	
1777	1905	Sand & Shale	
1905	1933	Anhydrite	
1933	2100	Sand & Shale	
2100	2420	Shale	
2420	2730	Shale & Lime	
2730	3222	Shale & Lime	
3222	3248	Lime	
3248	3280	Shale & Lime	DST #1
3280	3285	Shale & Lime	DST #2
3285	3365	Lime	
3365			DST #3
3365	3666	Lime	DST #4
3365	3415	Lime	
3415	3444	Lime & Shale	DST #5
3444	3551	Lime & Shale	
3551		Total Depth	D & A

RECEIVED  
STATE CORPORATION COMMISSION  
03-02-1970  
CONSERVATION DIVISION  
Wichita, Kansas

We certify the above and foregoing to be true and correct copy of the log on the #1 Hoover, located in Decatur County, Kansas

Bill Laker

President

Alma A. Neiser

Notary Public

Subscribed and sworn to before me this 27th day of February, 1970. My commission expires May 31, 1970