


Give All Information Completely
Make Required Affidavit
Mail or Deliver Report to:
Conservation Division
State Corporation Commission
211 No. Broadway
Wichita, Kansas

WELL PLUGGING RECORD

15-039-00133-00-00

Decatur County, Sec. 21 Twp. 1 Rge. 26 (E) (W) x

NORTH

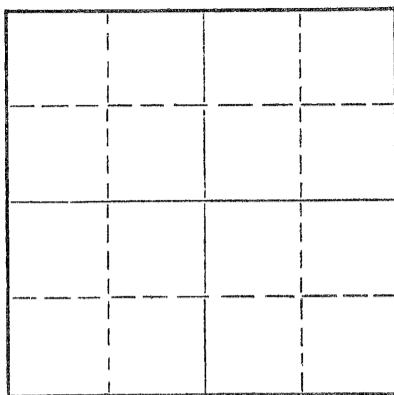

Locate well correctly on above
Section Plat

Location as "NE/CNW%SW%" or footage from lines C SW SW
Lease Owner Empire Drilling Company
Lease Name Kelley Well No. 1
Office Address 650 Fourth National Bank Building, Wichita 2, Kansas
Character of Well (completed as Oil, Gas or Dry Hole) Dry Hole
Date well completed April 25, 1961 19
Application for plugging filed April 25, 1961 19
Application for plugging approved April 25, 1961 19
Plugging commenced April 25, 1961 19
Plugging completed April 25, 1961 19
Reason for abandonment of well or producing formation Dry Hole

If a producing well is abandoned, date of last production _____ 19____
Was permission obtained from the Conservation Division or its agents before plugging was commenced? yes

Name of Conservation Agent who supervised plugging of this well A. D. Fabricius
Producing formation _____ Depth to top _____ Bottom _____ Total Depth of Well 3580 Feet
Show depth and thickness of all water, oil and gas formations.

OIL, GAS OR WATER RECORDS

CASING RECORD

FORMATION	CONTENT	FROM	TO	SIZE	PUT IN	PULLED OUT
	Shale	0	650	8 5/8"	136'	-0-

Describe in detail the manner in which the well was plugged, indicating where the mud fluid was placed and the method or methods used in introducing it into the hole. If cement or other plugs were used, state the character of same and depth placed, from _____ feet to _____ feet for each plug set.

Plug set at 300' with 20 sacks cement.
Plug set at 135' with 20 sacks cement.
Plug set at 40' with 10 sacks cement.

RECEIVED
STATE CORPORATION COMMISSION
05-02-1961
MAY 2 1961
CONSERVATION DIVISION
Wichita, Kansas

(If additional description is necessary, use BACK of this sheet)
Name of Plugging Contractor Empire Drilling Company
Address 650 Fourth National Bank Building, Wichita, Kansas

STATE OF KANSAS, COUNTY OF SEDGWICK, ss.
Dan J. Kornfeld (~~Empire Drilling Company~~) (owner or operator) of the above-described well, being first duly sworn on oath, says: That I have knowledge of the facts, statements, and matters herein contained and the log of the above-described well as filed and that the same are true and correct. So help me God.

(Signature) Dan J. Kornfeld
650-4th Nat'l. Bank Bldg., Wichita, Kansas
(Address)

SUBSCRIBED AND SWORN TO before me this 1st day of May, 19 61

My commission expires October 21, 1962 Lucille H. Harr Notary Public.



LOG

COMPANY: Empire Drilling Company 15-039-00133-00-00
 CONTRACTOR: Empire Drilling Company
 FARM: Kelley # 1
 LOCATION: C SW SW Sec. 21-1S-26W, Decatur County, Kansas
 COMMENCED: April 13, 1961 ELEVATION: 2506 KB
 COMPLETED: April 25, 1961 POTENTIAL: D & A

0	to	650	Shale
650	to	1000	Shale-Sand
1000	to	1070	Sand
1070	to	1450	Sand-Shale
1450	to	1953	Shale-Shells
1953	to	1981	Anhydrite
1981	to	2360	Shale-Shells
2360	to	2390	Shale-Lime
2390	to	2610	Shale-Shells
2610	to	2890	Shale-Lime
2890	to	2940	Lime
2940	to	3300	Lime-Shale
3300	to	3325	Lime-Chert
3325	to	3435	Lime-Shale
3435	to	3465	Lime
3465	to	3525	Lime-Shale
3525	to	3580	Lime
3580			Rotary Total Depth

SET: 136" 8 5/8" casing with 100 sacks cement.


ELECTRIC LOG TOPS:

Heebner	3238	- 732
Toronto	3274	- 768
Lansing	3282	- 776
Base Kansas City	3483	- 977
Granite Wash	3570	-1064
Granite	3578	-1072
Schlumberger TD	3583	


RECEIVED
 STATE CORPORATION COMMISSION
 05-02-1961
 MAY 2 1961
 CONSERVATION DIVISION
 Wichita, Kansas

CERTIFICATION

I, Dan J. Kornfeld, do hereby certify that the above and foregoing is a true and correct copy of the log on the Kelley # 1, C SW SW of Section 21-1S-26W, Decatur County, Kansas, as reflected by the files of Empire Drilling Company.

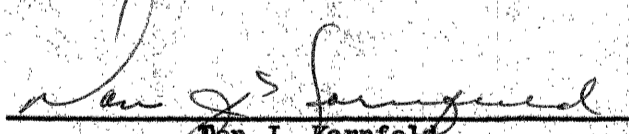
 Dan J. Kornfeld

Subscribed and sworn to before me, a Notary Public, within and for Sedgwick County, Kansas, this 1st day of May, 1961.


 Lucille H. Harr, Notary Public

My commission expires Oct. 21, 1962.