

CARD MUST BE TYPED

State of Kansas
NOTICE OF INTENTION TO DRILL
(see rules on reverse side)

CARD MUST BE SIGNED

Starting Date: 3 12 85
month day year

API Number 15- 039-10,761-00-00

OPERATOR: License # 5146
Name Rains & Williamson Oil Co., Inc.
Address 435 Page Court, 220 West Douglas
City/State/Zip Wichita, Kansas 67202
Contact Person Juanita Green
Phone (316) 265-9686

SW SE SE Sec 21 Twp 1 S, Rge 27
(location)
330 Ft North from Southeast Corner of Section
990 Ft West from Southeast Corner of Section
(Note: Locate well on Section Plat on reverse side)

CONTRACTOR: License # 5146
Name Same a Above
City/State

Nearest lease or unit boundary line 330 feet.
County Decatur
Lease Name METCALF "A" Well# 1
Domestic well within 330 feet : yes no
Municipal well within one mile : yes no

Well Drilled For: Well Class: Type Equipment:
 Oil Swd Infield Mud Rotary
 Gas Inj Pool Ext. Air Rotary
 OWWO Expl Wildcat Cable

Depth to Bottom of fresh water 120 feet
Lowest usable water formation Dakota
Depth to Bottom of usable water 1280 feet
Surface pipe by Alternate : 1 2
Surface pipe to be set 200 feet
Conductor pipe if any required -0- feet
Ground surface elevation feet MSL
This Authorization Expires 9-7-85
Approved By 3-7-85 [Signature]

If OWWO: old well info as follows:

Operator
Well Name
Comp Date Old Total Depth
Projected Total Depth 3550' feet
Projected Formation at TD Lansing
Expected Producing Formations Multi-zone Lansing

I certify that we will comply with K.S.A. 55-101, et seq., plus eventually plugging hole to K.C.C. specifications.

Date 2-6-85 Signature of Operator or Agent

[Signature: Wilson Rains]
WILSON RAINS

Title PRESIDENT


Form C-1 4/84

MHC/UDHE 3-8-85

**Must be filed with the K.C.C. five (5) days prior to commencing well
This card void if drilling not started within six (6) months of date received by K.C.C.**

Important procedures to follow :

**A Regular Section of Land
1 Mile = 5,280 Ft.**

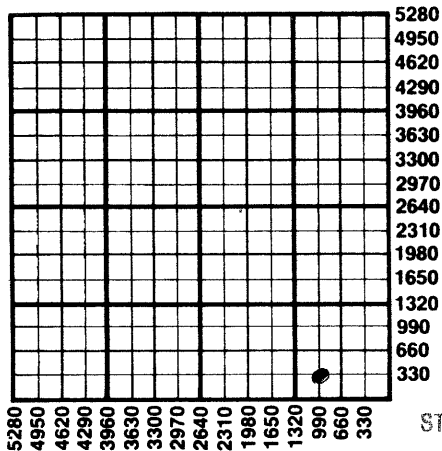

1. Notify District office before setting surface casing.
2. Set surface casing by circulating cement to the top.
3. File completion forms ACO-1 with K.C.C. within 90 days of well completion, following instructions on ACO-1, side 1, and including copies of wireline logs.
4. Notify District office 48 hours prior to old well workover or re-entry.
5. Prior to plugging, prepare a plugging plan, then obtain agreement from the appropriate district office for an approved plugging plan.
6. Submit plugging report (CP-4) to K.C.C. after plugging is completed.
7. Obtain an approved injection docket number before disposing of salt water.
8. Notify K.C.C. within 10 days when injection commences or terminates.
9. If an alternate 2 completion, cement in the production pipe from below any usable water to surface within 120 days of spud date.

RECEIVED
STATE CORPORATION COMMISSION

State Corporation Commission of Kansas
Conservation Division
200 Colorado Derby Building
Wichita, Kansas 67202
(316) 263-3238

MAR 07 1985
3-7-1985
CONSERVATION DIVISION
Wichita, Kansas