

STATE OF KANSAS
STATE CORPORATION COMMISSION


Give All Information Completely
Make Required Affidavit
Mail or Deliver Report to:
Conservation Division
State Corporation Commission
800 Biting Building
Wichita, Kansas

WELL PLUGGING RECORD

15-039-00439-00-00

Decatur County, Sec. 4 Twp. 1S Rge. 27W (E) (W)

Location as "NE/CNW&SW&" or footage from lines NW NW SE
Lease Owner Sauvage Drilling Co., Inc.
Lease Name Weatherwax Well No. 1
Office Address Oberlin, Kansas
Character of Well (completed as Oil, Gas or Dry Hole) Dry
Date well completed 11-29-60 19__
Application for plugging filed 11-29-60 19__
Application for plugging approved do 19__
Plugging commenced do 19__
Plugging completed do 8 PM 19__
Reason for abandonment of well or producing formation Dry

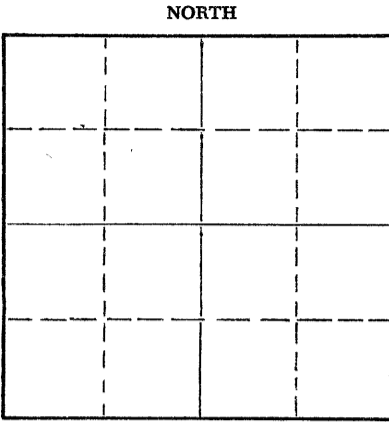

Locate well correctly on above
Section Plat

If a producing well is abandoned, date of last production _____ 19__
Was permission obtained from the Conservation Division or its agents before plugging was commenced? Yes

Name of Conservation Agent who supervised plugging of this well Al Fabricius, Hill, City, Kansas
Producing formation _____ Depth to top _____ Bottom _____ Total Depth of Well 3725 Feet
Show depth and thickness of all water, oil and gas formations.

OIL, GAS OR WATER RECORDS

CASING RECORD

FORMATION	CONTENT	FROM	TO	SIZE	PUT IN	PULLED OUT
			New	8-5/8"	281'	None

Describe in detail the manner in which the well was plugged, indicating where the mud fluid was placed and the method or methods used in introducing it into the hole. If cement or other plugs were used, state the character of same and depth placed, from _____ feet to _____ feet for each plug set.

Filled hole with heavy mud to 400 feet-set plug with 20 sax cement-filled to 275 feet-set plug with 20 sax cement-filled to 40 feet-set plug with 10 sax cement and filled with mud to bottom of cellar.

RECORDED
STATE CORPORATION COMMISSION
12-2-1960
DEC 2 1960

CONSERVATION DIVISION
Wichita, Kansas

(If additional description is necessary, use BACK of this sheet)
Name of Plugging Contractor Company tools
Address Oberlin, Kansas

STATE OF Kansas, COUNTY OF Decatur, ss.
Keith Gallatin (employee of owner) or (owner or operator) of the above-described well, being first duly sworn on oath, says: That I have knowledge of the facts, statements, and matters herein contained and the log of the above-described well as filed and that the same are true and correct. So help me God.

(Signature) Keith Gallatin
Oberlin, Kansas
(Address)

SUBSCRIBED AND SWORN TO before me this 1 day of December 19 60

My commission expires June 18, 1962

Janice Bryan
Notary Public.



OPERATOR Sauvage Drl'g Co., Inc.
FARM NAME Weatherwax
WELL NO. 1
CONTRACTOR Company tools
ROTARY COMM 11-21-60
ROTARY COMP 11-29-60

LOCATION: NW NW SE 4-1S-27W
Decatur Co Kans
CASING RECORD:
281' New 8-5/8"
Surface Casing

15-039-00439-00-00

Figures denote bottom of formation

Shale	830	
Shale & sand	1800	
Shale & shells	2539	
Anhydrite	2572	
Shale & shells	2667	
Lime & shale	2740	
Shale & shells	2840	
Shale & lime	3155	
Lime	3227	
Lime & shale	3275	
Lime	3610	
Shale & lime	3661	
Granite wash	3724	
Granite	3725	Total Depth

RECEIVED
STATE OF KANSAS COMMISSION
12-02-1960
DEC 2 1960
CONSERVATION DIVISION
Wichita, Kansas

STATE OF KANSAS)
)SS
COUNTY OF DECATUR)

I hereby certify that the foregoing is, to the best of my knowledge and belief, a true and correct drilling log as shown by the drilling reports in connection with the aforesaid well.

Keith Gallatin
Keith Gallatin

Subscribed and sworn to before me, the undersigned, a Notary Public, this 1 day of December, 1960

Janice Bryan
Janice Bryan Notary Public

My commission expires June 18, 1962.