

STATE OF KANSAS
STATE CORPORATION COMMISSION


15-039-20426-00-00

WELL PLUGGING RECORD

Give All Information Completely
Make Required Affidavit
Mail or Deliver Report to
Conservation Division
State Corporation Comm.
245 North Water
Wichita, KS 67202

Decatur County. Sec. 29 Twp. 18 Rge. 26W E/W
Location as "NE/CNW $\frac{1}{4}$ SW $\frac{1}{4}$ " or footage from lines 30' E &
110' N of NE SE NW

Lease Owner Lester Chambers
Lease Name Chambers Well No. 1
Office Address 310 E. Ash Oberlin, Kansas 67749
Character of Well (Completed as Oil, Gas or Dry Hole)
Dry Hole

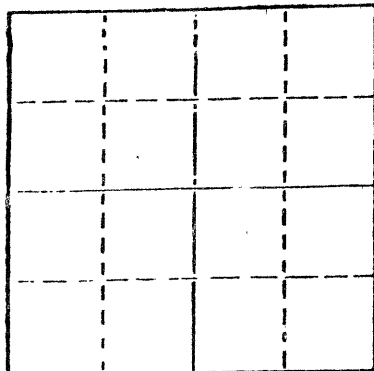

Locate well correctly on above
Section Plat

Date Well completed 7-6-78 19
Application for plugging filed 9-28-78 19
Application for plugging approved 19
Plugging commenced 1:00 P.M. 7-6-78 19
Plugging completed 2:45 P.M. 7-6-78 19
Reason for abandonment of well or producing formation

Non-commercial
If a producing well is abandoned, date of last production
not apply 19

Was permission obtained from the Conservation Division or
its agents before plugging was commenced? yes

Name of Conservation Agent who supervised plugging of this well Gilbert Balthazor Palco, Ks.
Producing formation None Depth to top Bottom Total Depth of Well 3611
Show depth and thickness of all water, oil and gas formations.

OIL, GAS OR WATER RECORDS

CASING RECORD

FORMATION	CONTENT	FROM	TO	SIZE	PUT IN	PULLED OUT
Surface				8 5/8	209	none

Describe in detail the manner in which the well was plugged, indicating where the mud fluid was placed and the method or methods used in introducing it into the hold. If cement or other plugs were used, state the character of same and depth placed, from _____ feet to _____ feet for each plug set.

Plug at 1400' w/ 70 sx. 50-50 poz. 6% gel
Plug at 200' w/ 20 sx. 50-50 poz. 6% gel
Plug at 40' w/ 10 sx. 50-50 poz. 6% gel

RECEIVED
STATE CORPORATION COMMISSION

OCT - 2 1978

CONSERVATION DIVISION
Wichita, Kansas

(If additional description is necessary, use BACK of this sheet)

Name of Plugging Contractor Halliburton

10-2-78


STATE OF Kansas COUNTY OF Decatur, ss.
employee of owner, James L. Reeves (employee of owner) or (owner or operator)
of the above-described well, being first duly sworn on oath, says: That I have knowledge of the facts, statements, and matters herein contained and the log of the above-described well as filed and that the same are true and correct. So help me God.

(Signature) James L. Reeves
P.O. Box 16 Oberlin, Ks 67749
(Address)

SUBSCRIBED AND SWORN TO before me this 29th day of September, 1978

Norma Soderlund
Notary Public.

My commission expires April 28, 1982

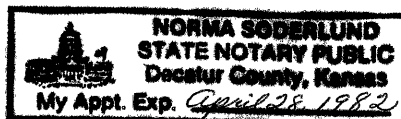

DRILLERS LOG

15-039-20426-00-00

Stoepfelwerth & Chambers
 #1 Chambers
 30'E & 110'N NE SE NW 29-1-26
 Decatur County, Kansas

Spud: July 1, 1978
 Surface: 8 5/8" @ 209 ft. w/ 200 sks 50-50 Pozmix, 2% gel, 2% Calcium Chloride @ 1:35pm 7-1-78
 Undersurface: 1:20am 7-2-78
 Reached T.D.: 7:00am 7-6-78 3598 ft.
 Plugs: 70 sks 50-50 Poz 6% gel @ 1400 ft.
 20 sks 50-50 Poz 6% gel @ 200 ft.
 10 sks 50-50 Poz 6% gel @ 40 ft.

0 - 180 surface sand and clay
 180 - 950 shale and limestone
 950 - 1700 sand and shale
 1700 - 1950 shale
 1960 - 1990 anhydrite
 1940 - 2230 shale
 2230 - 3080 lime and shale
 3080 - 3490 lime, sand and shale
 3490 - 3580 shale and limestone
 3580 - 3594 granite wash
 3594 - 3611 granite

I certify that the foregoing is a true and correct log of the above described well.



G. P. Stoepfelwerth, II
 President
 STOEPPELWERTH DRILLING, INC.

RECEIVED
 STATE CORPORATION COMMISSION

OCT - 2 1978
 10-2-78
 CONSERVATION DIVISION
 Wichita, Kansas