

STATE OF KANSAS  
 STATE CORPORATION COMMISSION  
 CONSERVATION DIVISION  
 P. O. BOX 17027  
 WICHITA, KANSAS 67217


15-039-20309-00-00

FORM CP-4

WELL PLUGGING RECORD

Decatur County, Sec. 28 Twp. 1S Rge. (X) 26 (W)

Location as "NE/CNW/SW" or footage from lines SE NE SW  
 Lease Owner Abercrombie Drilling, Inc.  
 Lease Name ERICKEY "A" Well No. #1  
 Office Address 801 Union Center, Wichita, Kansas 67202  
 Character of Well (completed as Oil, Gas or Dry Hole) Dry Hole  
 Date well completed July 3 19 75  
 Application for plugging filed (verbally) July 3 19 75  
 Application for plugging approved (verbally) July 3 19 75  
 Plugging commenced July 3 19 75  
 Plugging completed July 3 19 75  
 Reason for abandonment of well or producing formation No commercial quantity  
 of oil or gas encountered.

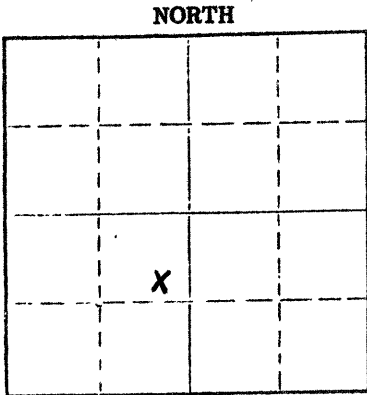

Locate well correctly on above Section Plat

If a producing well is abandoned, date of last production 19  
 Was permission obtained from the Conservation Division or its agents before plugging was commenced? Yes

Name of Conservation Agent who supervised plugging of this well Gilbert Balthazor  
 Producing formation \_\_\_\_\_ Depth to top \_\_\_\_\_ Bottom \_\_\_\_\_ Total Depth of Well 3582' Feet  
 Show depth and thickness of all water, oil and gas formations.

OIL, GAS OR WATER RECORDS

CASING RECORD

| FORMATION | CONTENT | FROM | TO | SIZE   | PUT IN | PULLED OUT |
|-----------|---------|------|----|--------|--------|------------|
|           |         |      |    | 8 5/8" | 225'   | None       |
|           |         |      |    |        |        |            |
|           |         |      |    |        |        |            |
Describe in detail the manner in which the well was plugged, indicating where the mud fluid was placed and the method or methods used in introducing it into the hole. If cement or other plugs were used, state the character of same and depth placed, from \_\_\_\_\_ feet to \_\_\_\_\_ feet for each plug set.

1st Plug Set @ 1100' with 70 sacks cement  
 2nd Plug Set @ 200' with 20 sacks cement  
 3rd Plug Set @ 40' with 10 sacks cement


(If additional description is necessary, use BACK of this sheet)

Name of Plugging Contractor Abercrombie Drilling, Inc.  
 Address 801 Union Center, Wichita, Kansas 67202

STATE OF KANSAS COUNTY OF SEDGWICK, ss.  
 Jerry A. Langrehr-Exec. V.P. (employee of owner) or (owner or operator) of the above-described well, being first duly sworn on oath, says: That I have knowledge of the facts, statements, and matters herein contained and the log of the above-described well as filed and that the same are true and correct. So help me God.

(Signature) Jerry A. Langrehr  
 801 Union Center, Wichita, Kansas  
 (Address)

Subscribed AND SWORN to before me this 8th day of July, 19 75

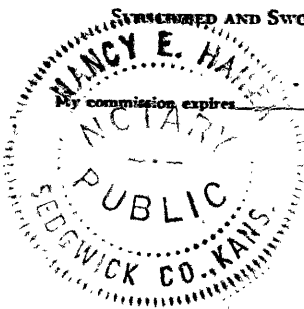

My commission expires April 8, 1978

Nancy E. Haner  
 Nancy E. Haner Notary Public.

RECEIVED  
 STATE CORPORATION COMMISSION  
 JUL 10 1975  
 CONSERVATION DIVISION  
 Wichita, Kansas