


STATE OF KANSAS  
STATE CORPORATION COMMISSION

Give All Information Completely  
Make Required Affidavit  
Mail or Deliver Report to:  
Conservation Division  
State Corporation Commission  
211 No. Broadway  
Wichita, Kansas

WELL PLUGGING RECORD

15-039-00193-00-00

NORTH

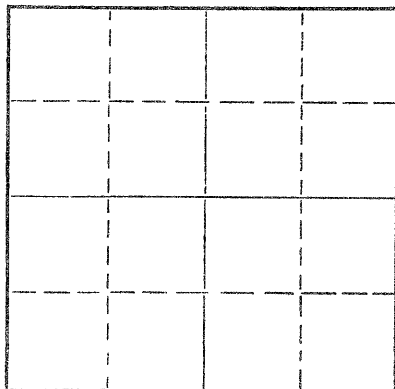

Locate well correctly on above  
Section Plat

Decatur County, Sec. 28 Twp. 15 Rge. (E) 27 (W)  
Location as "NE/CNW/SW" or footage from lines C SE NE  
Lease Owner Burch Exploration, Ltd.  
Lease Name CORCORAN Well No. 1  
Office Address 1011 Union Center, Wichita, Kansas  
Character of Well (completed as Oil, Gas or Dry Hole) Dry  
Date well completed November 22, 19 63  
Application for plugging filed verbally November 21, 19 63  
Application for plugging approved verbally November 21, 19 63  
Plugging commenced November 22, 19 63  
Plugging completed November 22, 19 63  
Reason for abandonment of well or producing formation Dry

If a producing well is abandoned, date of last production 19  
Was permission obtained from the Conservation Division or its agents before plugging was commenced? Yes

Name of Conservation Agent who supervised plugging of this well

Producing formation Depth to top Bottom Total Depth of Well 3600 Feet

Show depth and thickness of all water, oil and gas formations.

OIL, GAS OR WATER RECORDS

CASING RECORD

FORMATION	CONTENT	FROM	TO	SIZE	PUT IN	PULLED OUT
				8-5/8"	215'	None

Describe in detail the manner in which the well was plugged, indicating where the mud fluid was placed and the method or methods used in introducing it into the hole. If cement or other plugs were used, state the character of same and depth placed, from feet to feet for each plug set.

Filled hole with heavy mud to 600'.  
Set 1st plug at 600' w/ 20 sx cement.  
Set 2nd plug at 200' w/ 20 sx cement.  
Set top plug at 40' w/ 10 sx cement.

RECEIVED  
STATE CORPORATION COMMISSION

DEC 2 1963  
12-2-63  
CONSERVATION DIVISION  
Wichita, Kansas

(If additional description is necessary, use BACK of this sheet)  
Name of Plugging Contractor Abercrombie Drilling, Inc.  
Address 801 Union Center, Wichita, Kansas

12-2-1963

STATE OF Kansas, COUNTY OF Sedgwick, ss.  
B. Lynn Herrington (employee of owner) or (owner) or (operator) contractor  
well, being first duly sworn on oath, says: That I have knowledge of the facts, statements, and matters herein contained and the log of the above-described well as filed and that the same are true and correct. So help me God.

(Signature) B. Lynn Herrington  
801 Union Center, Wichita, Kansas.  
(Address)

SUBSCRIBED AND SWORN TO before me this 26th day of November, 19 63

My commission expires June 16, 1967

Leah Fayz Hoyle

Notary Public.



15-039-00193-00-00

CONTRACTOR'S WELL LOG

COMPANY: Burch Exploration, Ltd.  
 CONTRACTOR: Abercrombie Drilling, Inc.  
 FARM: CORCORAN #1  
 LOCATION: C SE NE Sec. 28-1S-27W  
 Decatur County, Kansas  
 COMMENCED: November 14, 1963  
 COMPLETED: November 22, 1963

0	230	Shale & Sand
230	1110	Shale
1110	1150	Shale & Shells
1150	1220	Hard Sand & Pyrite
1220	1520	Shale
1520	1767	Shale & Sand
1767	1862	Shale
1862	1895	Anhydrite
1895	1935	Shale
1935	2190	Shale & Lime Streaks
2190	2260	Sand & Shale
2260	2333	Shale & Lime Streaks
2333	2410	Lime & Shale
2410	2580	Shale
2580	2613	Anhydrite
2613	3153	Lime & Shale
3153	3201	Lime
3201	3419	Lime & Shale
3419	3495	Lime
3495	3585	Lime & Shale
3585	3600	Granite Wash
	3600	Rotary Total Depth

Set 8-5/8" surface casing at 215' w/165 sx HA-5 Sunset

DRY & ABANDONED

ELECTRIC LOG TOPS:

Severy	2988'	(- 536)
Topeka	3026'	(- 574)
Oread	3122'	(- 620)
Heebner	3135'	(- 683)
Douglas Sand	3150'	(- 698)
Lansing	3178'	(- 726)
Base Kansas City	3390'	(- 938)
Basal Sand	3522'	(-1070)
Granite Wash	3550'	(-1098)
Granite	3581'	(-1129)

ELEVATION: 2452' K. B.

RECEIVED  
 STATE CORPORATION COMMISSION  
 12-2-1963  
 DEC 2 1963  
 CONSERVATION DIVISION  
 Wichita, Kansas

STATE OF KANSAS )  
 ) SS  
 COUNTY OF SEDGWICK )

I, B. Lynn Herrington, do hereby certify that the above and foregoing is a true and correct copy of the log of the CORCORAN #1, C SE NE, Section 28-1S-27W, Decatur County, Kansas, as reflected by the files of Abercrombie Drilling, Inc.

*B. Lynn Herrington*  
 B. Lynn Herrington

Subscribed and sworn to before me, a Notary Public, in and for Sedgwick County, Kansas, this 26th day of November, 1963.

*Reah Lantz Hefke*  
 Notary Public

My commission expires 6/16/67