

CARD MUST BE TYPED

State of Kansas

CARD MUST BE SIGNED

NOTICE OF INTENTION TO DRILL

(see rules on reverse side)

Starting Date 1-21-87
month day year

API Number 15- 039-20,802-00-00

OPERATOR: License # 5313
Name F. & M. OIL CO., INC.
Address 422 Union Center
City/State/Zip Wichita, Ks., 67202
Contact Person Ronald S. Schraeder
Phone (316) 262-2636

SE. SW. NE. Sec... 36. Twp.. 1... S, Rg.. 30W.. West
..... 2970 Ft. from South Line of Section
..... 1650 Ft. from East Line of Section

(Note: Locate well on Section Plat on reverse side)

CONTRACTOR: License #
Name Unkown
City/State

Nearest lease or unit boundary line 1650 feet
County Decatur
Lease Name Anderson "H" Well # 1
Ground surface elevation Unkown feet MSL

Well Drilled For: Well Class: Type Equipment:
 Oil SWD Infield Mud Rotary
 Gas Inj Pool Ext. Air Rotary
 OWWO Expl Wildcat Cable

Domestic well within 330 feet: _____ yes no
Municipal well within one mile: _____ yes no
Surface pipe by Alternate: 1 2 _____
Depth to bottom of fresh water 100
Depth to bottom of usable water 200
Surface pipe planned to be set 310
Projected Total Depth 4250 feet
Formation Arbuckle

If OWWO: old well info as follows:

Operator
Well Name
Comp Date Old Total Depth

I certify that well will comply with K.S.A. 55-101, et seq., plus eventually plugging hole to KCC specifications.

_____ cementing will be done immediately upon setting production casing.

Date 12-10-86... Signature of Operator or Agent *X. P. J. [Signature]* Title... Vice-President

For KCC Use:

Conductor Pipe Required feet; Minimum Surface Pipe Required ¹⁰⁰ feet per Alt.


This Authorization Expires 6-11-87 Approved By 12-11-86 *[Signature]*

Must be filed with the K.C.C. five (5) days prior to commencing well
 This card void if drilling not started within six (6) months of date received by K.C.C.

Important procedures to follow:

1. Notify District office before setting surface casing.
2. Set surface casing by circulating cement to the top.
3. File completion forms ACO-1 with K.C.C. within 90 days of well completion, following instructions on ACO-1, side 1, and including copies of wireline logs.
4. Notify District office 48 hours prior to old well workover or re-entry.
5. Prior to filing Intent, prepare a proposed plugging plan in case well is D & A, then obtain approval of plan when calling district office prior to setting surface pipe.
6. Submit plugging report (CP-4) to K.C.C. after plugging is completed.
7. Obtain an approved injection docket number before disposing of salt water.
8. Notify K.C.C. within 10 days when injection commences or terminates.
9. If an alternate 2 completion, cement in the production pipe from below any usable water to surface within 120 days of spud date.

**A Regular Section of Land
 1 Mile = 5,280 Ft.**

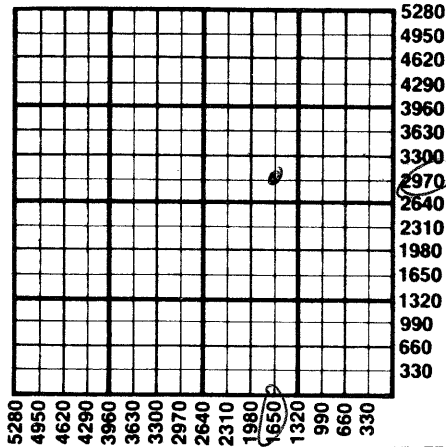

STATE CORPORATION COMMISSION

12-11-1986
 DEC 11 1986

CONSERVATION DIVISION
 Wichita, Kansas

State Corporation Commission of Kansas
 Conservation Division
 200 Colorado Derby Building
 Wichita, Kansas 67202
 (316) 263-3238