


STATE OF KANSAS  
STATE CORPORATION COMMISSION

15-039-20345-00-00  
WELL PLUGGING RECORD

Give All Information Completely  
Make Required Affidavit  
Mail or Deliver Report to  
Conservation Division  
State Corporation Comm.  
245 North Water  
Wichita, KS 67202

Decatur County. Sec. 23 Twp. 1S Rge. 26 ~~E~~W  
Location as "NE/CNW $\frac{1}{4}$ /SW $\frac{1}{4}$ " or footage from lines  
NW SW NE

Lease Owner Abercrombie Drilling, Inc.  
Lease Name HELEN COOK #1 Well No. \_\_\_\_\_  
Office Address 801 Union Center, Wichita, Kansas 67202  
Character of Well (Completed as Oil, Gas or Dry Hole) \_\_\_\_\_  
Dry Hole

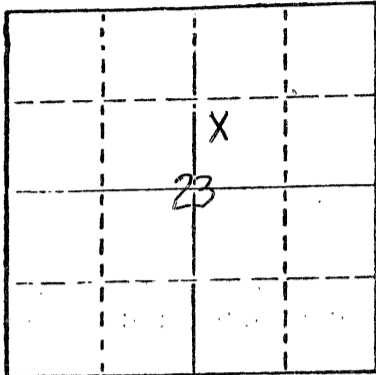

Locate well correctly on above  
Section Plot

Date Well completed July 6 1976  
Application for plugging filed (verbally) July 6 1976  
Application for plugging approved (verbally) July 6 1976  
Plugging commenced July 6 1976  
Plugging completed July 6 1976  
Reason for abandonment of well or producing formation  
No commercial quantity of oil or gas encountered.  
If a producing well is abandoned, date of last production  
19

Was permission obtained from the Conservation Division or  
its agents before plugging was commenced? Yes

Name of Conservation Agent who supervised plugging of this well Gilbert Balthazor  
Producing formation \_\_\_\_\_ Depth to top \_\_\_\_\_ Bottom \_\_\_\_\_ Total Depth of Well 3570'  
Show depth and thickness of all water, oil and gas formations.

OIL, GAS OR WATER RECORDS

CASING RECORD

FORMATION	CONTENT	FROM	TO	SIZE	PUT IN	PULLED OUT
				8-5/8"	210'	None

Describe in detail the manner in which the well was plugged, indicating where the mud fluid  
was placed and the method or methods used in introducing it into the hold. If cement or other  
plugs were used, state the character of same and depth placed, from \_\_\_\_\_ feet to  
\_\_\_\_\_ feet for each plug set.

1st Plug set @ 1000' with 70 sx.  
2nd Plug set @ 200' with 200 sx.  
3rd Plug set @ 40' with 10 sx.

RECEIVED  
STATE CORPORATION COMMISSION  
7-13-76  
JUL 13 1976

Plug was down @ 9:15 p.m. on July 6, 1976  
State Plugging: Gilbert Balthazor

CONSERVATION DIVISION  
WICHITA, KANSAS

(If additional description is necessary, use BACK of this sheet)

Name of Plugging Contractor Abercrombie Drilling, Inc.  
801 Union Center, Wichita, Kansas 67202

STATE OF KANSAS COUNTY OF SEDGWICK ss.  
Jerry A. Langrehr, Exec. V. P.

(employee of owner) or (owner or operator) of the above-described  
well, being first duly sworn on oath, says: That I have knowledge of the facts, statements, and matters herein contained and the log of the  
above-described well as filed and that the same are true and correct. So help me God.

(Signature)

801 Union Center, Wichita, Kansas 67202  
(Address)

CRUISED AND SWORN TO before me this 12th day of July 1976

July 21, 1979

Sandra Richman

Notary Public.

