

15-039-20265-00-00

STATE OF KANSAS  
STATE CORPORATION COMMISSION

Form CP-4


Give All Information Completely  
Make Required Affidavit  
Mail or Deliver Report to:  
Conservation Division  
State Corporation Commission

WELL PLUGGING RECORD

P. O. Box 17027  
Wichita, Kansas 67217  
NORTH

Decatur County, Sec. 22 Twp. 1S Rge. (E) 26 (W)

Location as "NE/CNW&SWX" or footage from lines NW NE  
Lease Owner Abercrombie Drilling, Inc.  
Lease Name RICHARDS Well No. 2  
Office Address 801 Union Center, Wichita, Kansas 67202  
Character of Well (completed as Oil, Gas or Dry Hole) Dry Hole  
Date well completed May 8, 19 73  
Application for plugging filed May 8, 19 73  
Application for plugging approved (verbally) May 8, 19 73  
Plugging commenced (verbally) May 8, 19 73  
Plugging completed May 8, 19 73  
Reason for abandonment of well or producing formation Dry Hole

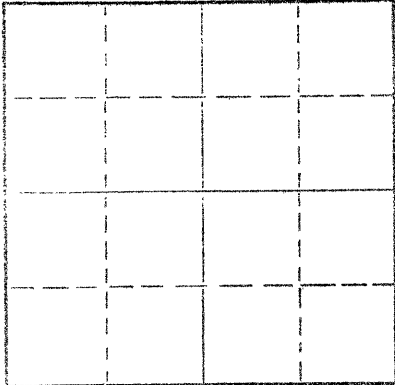

Locate well correctly on above  
Section Plat

If a producing well is abandoned, date of last production 19  
Was permission obtained from the Conservation Division or its agents before plugging was commenced? Yes

Name of Conservation Agent who supervised plugging of this well Bill Nichols  
Producing formation \_\_\_\_\_ Depth to top \_\_\_\_\_ Bottom \_\_\_\_\_ Total Depth of Well 3580 Feet  
Show depth and thickness of all water, oil and gas formations.

OIL, GAS OR WATER RECORDS

CASING RECORD

FORMATION	CONTENT	FROM	TO	SIZE	PUT IN	PULLED OUT
				8-5/8"	219'	None

Describe in detail the manner in which the well was plugged, indicating where the mud fluid was placed and the method or methods used in introducing it into the hole. If cement or other plugs were used, state the character of same and depth placed, from \_\_\_\_\_ feet to \_\_\_\_\_ feet for each plug set.

1st plug set at 1160' w/60 sx. cement  
2nd plug set at 245' w/20 sx. cement  
3rd plug set at 40' w/10 sx. cement  
Plug down at 12:15 a.m. 5-8-73.

RECEIVED  
STATE CORPORATION COMMISSION  
MAY 10 1973  
CONSERVATION DIVISION  
Wichita, Kansas

5-10-73

(If additional description is necessary, use BACK of this sheet)

Name of Plugging Contractor Abercrombie Drilling, Inc.  
Address 801 Union Center, Wichita, Kansas 67202

STATE OF KANSAS COUNTY OF SEDGWICK, ss.  
Jerry A. Langrehr (employee of owner) or (owner or operator) of the above-described well, being first duly sworn on oath, says: That I have knowledge of the facts, statements, and matters herein contained and the log of the above-described well as filed and that the same are true and correct. So help me God.

(Signature) Jerry A. Langrehr  
801 Union Center, Wichita, Kansas 67202  
(Address)

SUBSCRIBED AND SWORN TO before me this 9th day of May, 19 73

My commission expires February 10, 1975

Beverly Mann  
Beverly Mann, Notary Public.