


STATE OF KANSAS
STATE CORPORATION COMMISSION

WELL PLUGGING RECORD

Give All Information Completely
Make Required Affidavit
Mail or Deliver Report to
Conservation Division
State Corporation Comm.
245 North Water
Wichita, KS 67202

Decatur County, Sec. 15 Twp. 1S Rge. 26W E/W
Location as "NE/CNW $\frac{1}{4}$ SW $\frac{1}{4}$ " or footage from lines
150' W of C NW SE

Lease Owner Oxford Exploration
Lease Name Huff Well No. 15-10
Office Address 1550 Denver Club Bldg., Denver, CO 80202
Character of Well (Completed as Oil, Gas or Dry Hole)

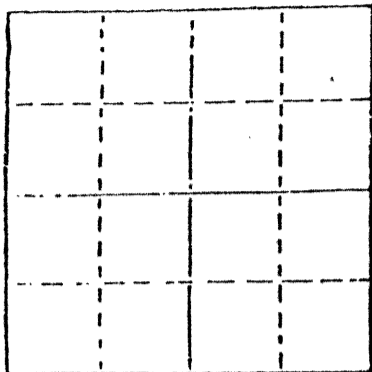

Locate well correctly on above
Section Plat

Dry Hole
Date Well completed 4-14-82 19
Application for plugging filed 4-14-82 19
Application for plugging approved 4-14-82 19
Plugging commenced 4-14-82 19
Plugging completed 4-14-82 19
Reason for abandonment of well or producing formation

Dry Hole
If a producing well is abandoned, date of last production 19

Was permission obtained from the Conservation Division or its agents before plugging was commenced? yes

Name of Conservation Agent who supervised plugging of this well Marion Schmidt
Producing formation _____ Depth to top _____ Bottom _____ Total Depth of Well 348
Show depth and thickness of all water, oil and gas formations.


OIL, GAS OR WATER RECORDS

CASING RECORD

FORMATION	CONTENT	FROM	TO	SIZE	PUT IN	PULLED OUT
surface				8-5/8"	122'	none

Describe in detail the manner in which the well was plugged, indicating where the mud fluid was placed and the method or methods used in introducing it into the hold. If cement or other plugs were used, state the character of same and depth placed, from _____ feet to _____ feet for each plug set.

- 1st plug @ 1050' w/80 sx.
- 2nd plug @ 240' w/40 sx.
- 3rd plug @ 40' w/10 sx.
- 10 sx in rat hole

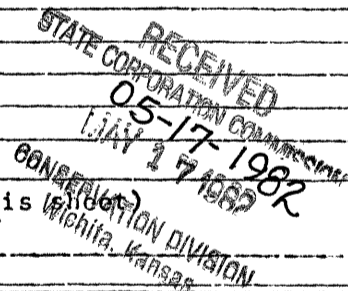

(If additional description is necessary, use BACK of this)

Name of Plugging Contractor Murfin Drilling Company

STATE OF KANSAS COUNTY OF SEDGWICK, ss.

David L. Murfin, Drlg. Mgr., Murfin Drlg. Co. (employee of owner) or (owner or operator of the above-described well, being first duly sworn on oath, says: That I have knowledge of the facts, statements, and matters herein contained and the log of the above-described well as filed and that the same are true and correct. So help me God.



(Signature)

David L. Murfin, Drilling Manager

617 Union Ctr. Bldg., (Address) Wichita, KS 67202

SUBSCRIBED AND SWORN TO before me this 26th day of April, 19 82

Laurel Davis
Laurel Davis

Notary Public.

My commission expires 12-19-84