

15-039-20302-00-00

WELL PLUGGING RECORD

Decatur County, Sec. 14 Twp. 1S Rge. XX 26 (W)

Location as "NE/CNW/SW" or footage from lines NE NE SE

Lease Owner Jerome P. McHugh

Lease Name COZAD Well No. #1

Office Address P.O. Box 6334, Denver, Colorado 80206

Character of Well (completed as Oil, Gas or Dry Hole) Dry Hole

Date well completed March 23 1975

Application for plugging filed (verbal) March 23 1975

Application for plugging approved March 23 1975


Plugging commenced March 23 1975

Plugging completed March 23 1975

Reason for abandonment of well or producing formation No commercial quantities of gas or oil encountered

If a producing well is abandoned, date of last production 19

Was permission obtained from the Conservation Division or its agents before plugging was commenced? Yes

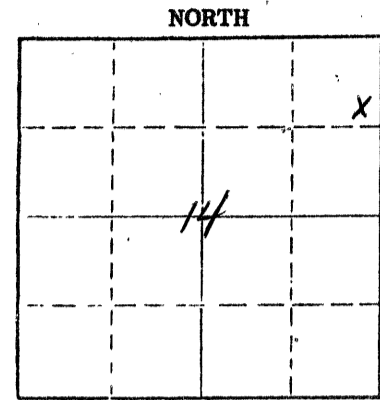

Locate well correctly on above Section Plat

Name of Conservation Agent who supervised plugging of this well Gilbert Balthazor

Producing formation Depth to top Bottom Total Depth of Well 3525 Feet

Show depth and thickness of all water, oil and gas formations.

OIL, GAS OR WATER RECORDS

CASING RECORD

FORMATION	CONTENT	FROM	TO	SIZE	PUT IN	PULLED OUT
				8-5/8"	255'	None

Describe in detail the manner in which the well was plugged, indicating where the mud fluid was placed and the method or methods used in introducing it into the hole. If cement or other plugs were used, state the character of same and depth placed, from feet to feet for each plug set.

1st Plug Set @ 960' with 70 sx. cement

2nd Plug Set @ 240' with 20 sx.

3rd Plug Set @ 40' with 10 sx.

RECEIVED  
 STATE CORPORATION COMMISSION

MAR 27 1975

03-27-1975

CONSERVATION DIVISION  
 Wichita, Kansas

Name of Plugging Contractor (If additional description is necessary, use BACK of this sheet) Abercrombie Drilling, Inc.

Address 801 Union Center, Wichita, Kansas 67202

STATE OF KANSAS COUNTY OF SEDGWICK ss. Jerry A. Langrehr, V.P.


(employee of owner) or (owner or operator) of the above-described well, being first duly sworn on oath, says: That I have knowledge of the facts, statements, and matters herein contained and the log of the above-described well as filed and that the same are true and correct. So help me God.

(Signature) Jerry A. Langrehr  
 801 Union Center, Wichita, Ks. 67202  
 (Address)

SUBSCRIBED AND SWORN TO before me this 25th day of March 1975

April 8, 1978

Nancy E. Haner  
 Nancy E. Haner  
 Notary Public.

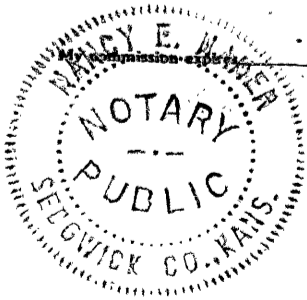

CONTRACTOR'S WELL LOG

15-039-20302-00-00

OPERATOR:	Jerome P. McHugh
CONTRACTOR:	Abercrombie Drilling, Inc.
WELL NAME:	COZAD #1
LOCATION:	NE NE SE Section 14-1S-26W Decatur County, Kansas
GEOLOGIST:	Charles Johnson
SPUD DATE:	March 15, 1975
COMPLETION DATE:	March 23, 1975

0	40	Clay & Sand
40	50	Sand & Clay
50	1515	Shale
1515	1615	Sand
1615	1836	Shale
1836	1866	Anhydrite
1866	2425	Shale
2425	3497	Lime & Shale
3497	3525	Shale
	3525	Rotary Total Depth

**RECEIVED**  
STATE CORPORATION COMMISSION

MAR 27 1975  
03-27-1975  
CONSERVATION DIVISION  
Wichita, Kansas

Drilled 256' of 12½" surface hole. Set 8-5/8" casing @ 255'. Cemented with 160 Sx. Quick-Set; cement circulated. Plug down @8:30 p.m., March 15, 1975.  
Plugged & Abandoned: Set 1st Plug @960' with 70 sx. cement, 2nd Plug @240' with 20 sx., 3rd Plug @ 40' with 10 sx. Plug down @6:00 a.m., March 23, 1975.

Sample Tops	Elevation
Anhydrite 1836 (+525)	2361' K.B.
B/Anhydrite 1866 (+495)	2359' D.F.
	2353' G.L.

STATE OF KANSAS        )  
                                  )   SS  
COUNTY OF SEDGWICK )

Jerry A. Langrehr, Vice President of Abercrombie Drilling, Inc. does hereby state that the above and foregoing is a true and correct copy of the log of the COZAD #1, NE NE SE Section 14-1S-26W, Decatur County, Kansas.

ABERCROMBIE DRILLING, INC.

By: Jerry A. Langrehr  
Jerry A. Langrehr  
Executive Vice President

Subscribed and sworn to before me a Notary Public. in and for the afore-said county and state as of this 25th day of March, 1975.

Nancy E. Haner  
Nancy E. Haner, Notary Public

