


STATE OF KANSAS
STATE CORPORATION COMMISSION

WELL PLUGGING RECORD 15-039-20344-00-00

Give All Information Completely
Make Required Affidavit
Mail or Deliver Report to
Conservation Division
State Corporation Comm.
245 North Water
Wichita, KS 67202

Decatur County. Sec. 14 Twp. 1S Rge. 26 E/W
Location as "NE/CNW $\frac{1}{4}$ SW $\frac{1}{4}$ " or footage from lines _____
SW SW NE
Lease Owner A. L. Abercrombie, Inc.
Lease Name COZAD Well No. 2
Office Address 801 Union Center, Wichita, KS 67202
Character of Well (Completed as Oil, Gas or Dry Hole) _____
Dry Hole

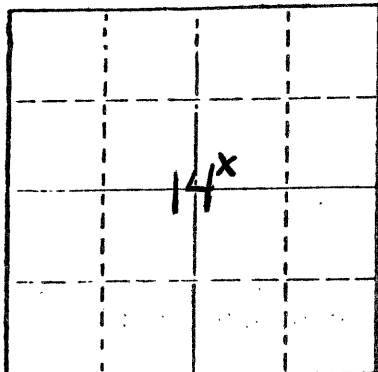

Locate well correctly on above Section Plat

Date Well completed June 29 1976
Application for plugging filed (verbally) June 29 1976
Application for plugging approved (verbally) June 29 1976
Plugging commenced June 29 1976
Plugging completed June 29 1976
Reason for abandonment of well or producing formation _____
No commercial quantity of oil or gas encountered.
If a producing well is abandoned, date of last production _____
19 _____

Was permission obtained from the Conservation Division or its agents before plugging was commenced? Yes

Name of Conservation Agent who supervised plugging of this well Gilbert Balthazor
Producing formation _____ Depth to top _____ Bottom _____ Total Depth of Well 3513'
Show depth and thickness of all water, oil and gas formations.

OIL, GAS OR WATER RECORDS

CASING RECORD

FORMATION	CONTENT	FROM	TO	SIZE	PUT IN	PULLED OUT
				8-5/8"	217 K.B.	None

Describe in detail the manner in which the well was plugged, indicating where the mud fluid was placed and the method or methods used in introducing it into the hold. If cement or other plugs were used, state the character of same and depth placed, from _____ feet to _____ feet for each plug set.

Plug to Abandon
1st Plug set @ 900' with 70 sx.
2nd Plug set @ 200' with 20 sx.
3rd Plug set @ 40' with 10 sx.

Plug was down @ 2:45 a.m. on June 29, 1976
State Plugger: Gilbert Balthazor

(If additional description is necessary, use BACK of this sheet)

Name of Plugging Contractor Abercrombie Drilling, Inc.
801 Union Center, Wichita, Kansas 67202

STATE OF KANSAS COUNTY OF SEDGWICK ss.
Jerry A. Langrehr, Exec. V. P.

(employee of owner) or (owner or operator) of the above-described well, being first duly sworn on oath, says: That I have knowledge of the facts, statements, and matters herein contained and the log of the above described well as filed and that the same are true and correct. So help me God.

(Signature) Jerry A. Langrehr
801 Union Center, Wichita, KS 67202
(Address)

1st day of July 19 76

Sandra Richman
Sandra Richman Notary Public.

July 21, 1979

