

STATE CORPORATION COMMISSION OF KANSAS  
OIL & GAS CONSERVATION DIVISION  
WELL COMPLETION OR RECOMPLETION FORM  
ACO-1 WELL HISTORY  
DESCRIPTION OF WELL AND LEASE

Operator: License # 6033  
Name MURFIN DRILLING COMPANY  
Address 250 N. Water, Suite 300  
City/State/Zip Wichita, Ks. 67202

Purchaser

Operator Contact Person Todd Aikins  
Phone 316-267-3241

Contractor: License # 6033  
Name Murfin Drilling Company

Wellsite Geologist Roger Welty  
Phone 913-674-5835

Designate Type of Completion  
 New Well  Re-Entry  Workover  
 Oil  SWD  Temp Abd  
 Gas  Inj  Delayed Comp.  
 Dry  Other (Core, Water Supply etc.)

If ONWO: old well info as follows:  
Operator  
Well Name  
Comp. Date Old Total Depth

WELL HISTORY

Drilling Method:  
 Mud Rotary  Air Rotary  Cable  
1-4-89 1-20-89 1-21-89  
Spud Date Date Reached TD Completion Date  
3799'  
Total Depth PBTD  
8-5/8" @ 267'  
Amount of Surface Pipe Set and Cemented at...feet  
Multiple Stage Cementing Collar Used? Yes No  
If yes, show depth set...feet  
If alternate 2 completion, cement circulated from...feet depth to...w/...SX cmt  
Cement Company Name  
Invoice #  
A-I-D-#

API NO. 15-15-039-20.837-00-00  
County Decatur  
SE NW SE Sec. 20 Twp. 1S Rge. 29 East  
X West

1650' Ft North from Southeast Corner of Section  
1650' Ft West from Southeast Corner of Section  
(Note: Locate well in section plat below)


Lease Name ASCHWEGE Well # 1-20

Field Name

Producing Formation

Elevation: Ground 2578 KB 2583

Section Plat

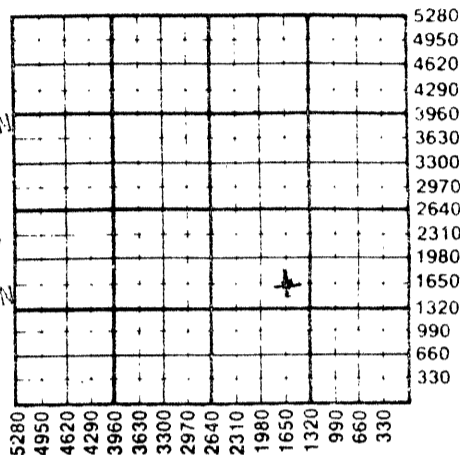

RECEIVED  
STATE CORPORATION COMMISSION  
MAR 16 1989  
3-16-1989  
CONSERVATION DIVISION  
Wichita, Kansas

WATER SUPPLY INFORMATION

Disposition of Produced Water: Disposal  
Docket # Repressuring

Questions on this portion of the ACO-1 call:

Water Resources Board (913) 296-3717

Source of Water:  
Division of Water Resources Permit #

Groundwater...Ft North from Southeast Corner  
(Well) ...Ft West from Southeast Corner of  
Sec Twp Rge East West

Surface Water...Ft North from Southeast Corner  
(Stream, pond etc)...Ft West from Southeast Corner  
Sec Twp Rge East West

X Other (explain) Water was hauled in  
(purchased from city, R.W.D. #)

INSTRUCTIONS: This form shall be completed in triplicate and filed with the Kansas Corporation Commission, 200 Colorado Derby Building, Wichita, Kansas 67202, within 120 days of the spud date of any well. Rule 82-3-130, 82-3-107 and 82-3-106 apply. Information on side two of this form will be held confidential for a period of 12 months if requested in writing and submitted with the form. See rule 82-3-107 for confidentiality in excess of 12 months. One copy of all wireline logs and drillers time log shall be attached with this form. Submit CP-4 form with all plugged wells. Submit CP-111 form with all temporarily abandoned wells.

All requirements of the statutes, rules and regulations promulgated to regulate the oil and gas industry have been fully complied with and the statements herein are complete and correct to the best of my knowledge.

Signature Todd Aikins  
Title Geologist Date 3-6-89

Subscribed and sworn to before me this 7th day of March 1989.  
Notary Public Glenda G. Newell

Date Commission Expires 7/2/89

GLEIDA G. NEWELL  
Notary Public  
My Exp. 7-2-89

K.C.C. OFFICE USE ONLY  
 Letter of Confidentiality Attached  
 Wireline Log Received  
 Drillers Timelog Received  
Distribution  
 KCC  SWD/Rep  NGPA  
 KGS  Plug  Other  
(Specify)  
3-16-89  
Form ACO-1 (5-86)

Sec 20 Twp 1 S Rge 29 E