


Give All Information Completely
Make Required Affidavit
Mail or Deliver Report to:
Conservation Division
State Corporation Commission
211 No. Broadway
Wichita, Kansas

15-039-00484-00-00

WELL PLUGGING RECORD

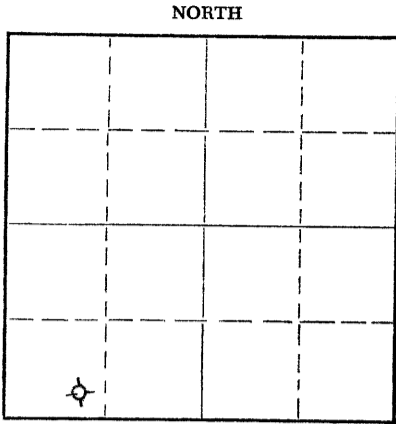

Locate well correctly on above
Section Plat

Decatur County, Sec. 1 Twp. 1 Rge. 27 (E) W (W)
Location as "NE/CNW/SW" or footage from lines SE SW SW
Lease Owner D. G. Hansen
Lease Name Sater Well No. 5
Office Address Logan, Kansas
Character of Well (completed as Oil, Gas or Dry Hole) Dry Hole
Date well completed December 19 1956
Application for plugging filed December 19 1956
Application for plugging approved December 19 1956
Plugging commenced December 19 1956
Plugging completed December 19 1956
Reason for abandonment of well or producing formation _____

If a producing well is abandoned, date of last production _____ 19____
Was permission obtained from the Conservation Division or its agents before plugging was commenced? Yes

Name of Conservation Agent who supervised plugging of this well Edon Petty, Hays, Kansas
Producing formation _____ Depth to top _____ Bottom _____ Total Depth of Well 3650 Feet
Show depth and thickness of all water, oil and gas formations.

OIL, GAS OR WATER RECORDS

CASING RECORD

FORMATION	CONTENT	FROM	TO	SIZE	PUT IN	PULLED OUT
				8-5/8"	297'	none

Describe in detail the manner in which the well was plugged, indicating where the mud fluid was placed and the method or methods used in introducing it into the hole. If cement or other plugs were used, state the character of same and depth placed, from _____ feet to _____ feet for each plug set.

Filled hole with heavy mud to 292'.
Set plug. Put in 1/2 sack Hulls &
15 sacks Cement. Filled with heavy
mud up to 40. Set plug. Filled to
top with 1/2 sack Hulls & 10 sacks
cement.

RECEIVED
STATE CORPORATION COMMISSION
12-29-1956
DEC 29 1956
CONSERVATION DIVISION
Wichita, Kansas

(If additional description is necessary, use BACK of this sheet)
Name of Plugging Contractor C-G Drilling Co.
Address 107 Rule Building, Wichita, Kansas

STATE OF KANSAS, COUNTY OF SEDGWICK, ss.
Jay H. Galloway (employee of owner) or (owner or operator) of the above-described well, being first duly sworn on oath, says: That I have knowledge of the facts, statements, and matters herein contained and the log of the above-described well as filed and that the same are true and correct. So help me God.

(Signature) Jay H. Galloway
Jay H. Galloway
107 Rule Bldg.
(Address)

SUBSCRIBED AND SWORN TO before me this 26th day of December, 1956

My commission expires May 20, 1959

Vicky Jacobs
Vicky Jacobs
Notary Public.

PLUGGING
FILE SEC. 1 T 1 R 27W
BOOK PAGE 128 LINE 29

15-039-00484-00-00

CONTRACTOR'S WELL LOG

OPERATOR D. G. Hansen

WELL NAME Sater #5

LOCATION SE SW SW Sec. 1-1-27W

RIG NO. 1

COUNTY Decatur

STATE Kansas

COMMENCEMENT DATE December 11, 1956

COMPLETION DATE December 19, 1956

LOG OF WELL

Elevation 2542' Rotary bushing.
All measurements taken from the top of rotary bushing.

FROM	TO	FORMATION	DEVIATION FROM VERTICAL	REMARKS:
0	297	Surface Soil		
297	1075	Shale-Sand		
1075	1400	Sand-Shale		
1400	1700	Shale-Sand		
1700	1960	Shale-Lime		
1960	1990	Anhydrite		
1990	2220	Lime-Shale		
2220	2400	Lime		
2400	2575	Lime-Shale	0° - 2500	
2575	2700	Shale-Lime		
2700	2800	Lime-Shale	0° - 2750	
2800	2900	Lime-Shale		
2900	3055	Lime-Shale	0° - 3000	
3055	3197	Lime-Shale		
3197	3300	Lime-Shale	0° - 3250	
3300	3390	Lime-Shale		
3390	3410	Lime-Shale		DST 3281-3300
3410	3545	Lime-Shale	0° - 3500	DST 3379-3410 packer failure
3545	3650	Lime-Shale		DST 3340-3410

CASING LEFT IN HOLE AFTER COMPLETION

Ran 297' (15 jts.) 8-5/8" OD Surface Casing.

RECEIVED
STATE CORPORATION COMMISSION
12-29-1956
DEC 29 1956

CONSERVATION DIVISION
Wichita, Kansas

STATE OF KANSAS }
COUNTY OF SEDGWICK } SS.

The undersigned hereby certifies that to the best of her knowledge and belief, the above facts are true and correct.

C-G DRILLING CO.

By Jay H. Galloway
Jay H. Galloway

Subscribed and sworn to before me this 26th day of December, 1956.

My commission expires:
May 20, 1959

Vicky Jacobs
Vicky Jacobs, Notary Public

PLUGGING
FILE SEC 1 1 1 R 27W
BOOK PAGE 128 LINE 29