


15-039-20436-00-00

STATE OF KANSAS  
STATE CORPORATION COMMISSION

WELL PLUGGING RECORD

Give All Information Completely  
Make Required Affidavit  
Mail or Deliver Report to  
Conservation Division  
State Corporation Comm.  
245 North Water  
Wichita, KS 67202

Decatur County. Sec. 35 Twp. 1 Rge. 26 E/W  
Location as "NE/CNW $\frac{1}{4}$ SW $\frac{1}{4}$ " or footage from lines C NE NE  
Lease Owner A. Scott Ritchie  
Lease Name Rubendall #1 Well No. \_\_\_\_\_  
Office Address Lyons, Kansas 67554  
Character of Well (Completed as Oil, Gas or Dry Hole) \_\_\_\_\_

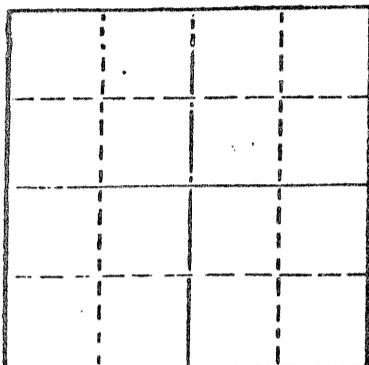

Locate well correctly on above Section Plot

Date Well completed \_\_\_\_\_ 19\_\_\_\_  
Application for plugging filed \_\_\_\_\_ 19\_\_\_\_  
Application for plugging approved \_\_\_\_\_ 19\_\_\_\_  
Plugging commenced 5/31/79 \_\_\_\_\_ 19\_\_\_\_  
Plugging completed 6/6/79 \_\_\_\_\_ 19\_\_\_\_  
Reason for abandonment of well or producing formation \_\_\_\_\_  
depleted.

If a producing well is abandoned, date of last production \_\_\_\_\_ 19\_\_\_\_

Was permission obtained from the Conservation Division or its agents before plugging was commenced? yes

Name of Conservation Agent who supervised plugging of this well Balthazor  
Producing formation \_\_\_\_\_ Depth to top \_\_\_\_\_ Bottom \_\_\_\_\_ Total Depth of Well 3773  
Show depth and thickness of all water, oil and gas formations.

OIL, GAS OR WATER RECORDS

CASING RECORD

FORMATION	CONTENT	FROM	TO	SIZE	PUT IN	PULLED OUT
				8-5/8	261	none
				5 1/2"	3770	1817'

Describe in detail the manner in which the well was plugged, indicating where the mud fluid was placed and the method or methods used in introducing it into the hold. If cement or other plugs were used, state the character of same and depth placed, from \_\_\_\_\_ feet to \_\_\_\_\_ feet for each plug set.

Ran 5 sacks cement on bottom. Shot pipe at 2968', Halliburton pumped nitrage in casing to try to get it loose. Shot pipe at 2031', 1814', pulled 72 joints. Allied pumped 3 sacks hulls, 70 sacks cement, 16 sacks gel, plug and 60 sacks cement.

PLUGGING COMPLETE.

(If additional description is necessary, use BACK of this sheet)

Name of Plugging Contractor KELSO CASING PULLING  
CHASE KANSAS

STATE OF KANSAS COUNTY OF RICE, ss.  
R. DARRELL KELSO (employee of owner) or (owner or operator)  
of the above-described well, being first duly sworn on oath, says: That I have knowledge of the facts, statements, and matters herein contained and the log of the above-described well as filed and that the same are true and correct. So help me God.

(Signature) [Signature]  
CHASE, KANSAS  
(Address)

SUBSCRIBED AND SWORN TO before me this 13th day of June, 19 79

My commission expires \_\_\_\_\_



RECEIVED  
STATE CORPORATION COMMISSION  
[Signature]  
Notary Public.

JUN 15 1979  
6-15-79  
CONSERVATION DIVISION  
Wichita, Kansas

WELL LOG

15-039-20436-00-00

COMPANY A. Scott Ritchie

SEC. 35 T. 1S R. 26W  
LOC. C NE NE


FARM RUBENDALL NO. 1

RIG. NO. 2

TOTAL DEPTH 3774

COMM. December 6, 1978 COMP. December 16, 1978

COUNTY Decatur KANSAS

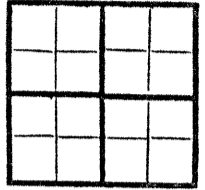

CONTRACTOR Murfin Drilling Company

CASING  
20 10  
15 8 -5/8" @ 261' w/200 sx.  
12 6  
13 5 1/2" @ 3770' w/100 sx.

ELEVATION

PRODUCTION

FIGURES INDICATE BOTTOM OF FORMATIONS

215'	Clay & Sand
287'	Shale
1725'	Shale & Sand
2072'	Sand & Shale
2100'	Anhydrite
2835'	Shale & Shells
3000'	Shale
3255'	Shale & Lime
3395'	Lime
3458'	Lime & Shale
3492'	Lime
3550'	Shale & Lime
3626'	Lime
3744'	Lime & Shale
3749'	Sand
3774'	Lime RTD

RECEIVED  
STATE CORPORATION COMMISSION

MAY - 7 1979

5-7-1979

CONSERVATION DIVISION  
Wichita, Kansas

State of KANSAS  
County of SEDGWICK ss:

I, Wm. S. Shropshire of the Murfin Drilling Company

upon oath state that the above and foregoing is a true and correct copy of the log of the RUBENDALL #1 well.

Wm. S. Shropshire  
Wm. S. Shropshire, Asst. Gen. Mgr.

Subscribed and sworn to before me this 28th day of December 19 78

My Commission Expires:

SANDRA KAY MAY  
NOTARY PUBLIC  
Butler County, Kansas  
My Appt. Exp. 6-5-88

Sandra Kay May  
NOTARY PUBLIC  
Sandra Kay May