


STATE OF KANSAS
STATE CORPORATION COMMISSION

Give All Information Completely
Make Required Affidavit
Mail or Deliver Report to:
Conservation Division
State Corporation Commission
211 No. Broadway
Wichita, Kansas

15-039-00132-00-00
WELL PLUGGING RECORD

NORTH

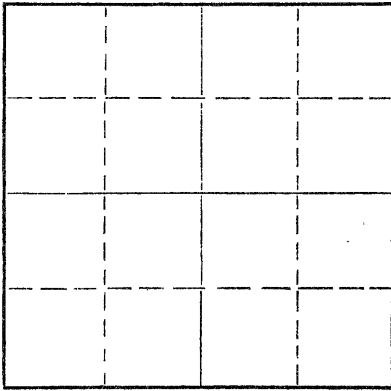

Locate well correctly on above
Section Plat

Decatur County. Sec. 36 Twp. 1 Rge. 26 (X) (W)

Location as "NE/CNW/SW" or footage from lines. C SE SW

Lease Owner Woodman & Iannitti Drlg. Co.

Lease Name Van Gundy Well No. 1

Office Address 714 Union Nat'l. Bldg., Wichita

Character of Well (completed as Oil, Gas or Dry Hole) _____

Date well completed Nov. 20 1961

Application for plugging filed Nov. 20 1961

Application for plugging approved Nov. 20 1961

Plugging commenced Nov. 20 1961

Plugging completed Nov. 20 1961

Reason for abandonment of well or producing formation dry

If a producing well is abandoned, date of last production _____ 19____

Was permission obtained from the Conservation Division or its agents before plugging was commenced? yes

Name of Conservation Agent who supervised plugging of this well Eldon Petty

Producing formation _____ Depth to top _____ Bottom _____ Total Depth of Well 3770 Feet

Show depth and thickness of all water, oil and gas formations.

OIL, GAS OR WATER RECORDS

CASING RECORD

FORMATION	CONTENT	FROM	TO	SIZE	PUT IN	PULLED OUT
				8 5/8	226'	

Describe in detail the manner in which the well was plugged, indicating where the mud fluid was placed and the method or methods used in introducing it into the hole. If cement or other plugs were used, state the character of same and depth placed, from _____ feet to _____ feet for each plug set.

Bottom Plug 540' w/20 sx cement
Middle Plug 200' w/20 sx cement
Top Plug 35' 2/10 sx cement

RECORDED
STATE CORPORATION COMMISSION
11-27-61
NOV 27 1961

CONSERVATION DIVISION
Wichita, Kansas

(If additional description is necessary, use BACK of this sheet)
Name of Plugging Contractor Woodman & Iannitti Drilling Co. 11-27-1961
Address 714 Union Nat'l. Bldg., Wichita

STATE OF Kansas, COUNTY OF Sedgwick, ss.
K. T. Woodman (employee of owner) or (owner or operator) of the above-described

well, being first duly sworn on oath, says: That I have knowledge of the facts, statements, and matters herein contained and the log of the above-described well as filed and that the same are true and correct. So help me God.

(Signature) K. T. Woodman

714 Union Nat'l. Bldg., Wichita

(Address)

SUBSCRIBED AND SWORN TO before me this 24th day of November, 1961

Frances A. Solomon

Notary Public.

My commission expires Oct. 10, 1963



15-039-00132-00-00

RECORDED
NOV 27 1961

DRILLING LOG

CONSERVATION DIVISION
Wichita, Kansas

Company: Woodman & Iannitti Drilling Co.
 Lease: #1 VAN GUNDY C SE SW 36-1-26W, Decatur County, Kansas
 Contractor: Woodman & Iannitti Drilling Co.
 Date Commenced: 11-13-61
 Date Completed: 11-20-61
 Total Depth: 3770 (Driller) 3773 (Log)
 Casing: 8 5/8 @ 226' w/148 sax cement

Figures Indicate the Bottom of Formation

0 - 100	Clay	2046	Red Bed
200	Sand	2075	Anhydrite
840	Shale	2415	Shale
1100	Blue Shale	2750	Lime & Shale
1680	Shale & Sand	3745	Lime
1705	Red Bed & Shale	3770	Granite Wash
1815	Sand		

I certify the above to be a true and correct copy of the Driller's Log to the best of my knowledge and belief.

WOODMAN & IANNITTI DRILLING COMPANY

By: X. T. Woodman
 K. T. Woodman