


15-039-00007-00-00

Give All Information Completely
Make Required Affidavit
Mail or Deliver Report to:
Conservation Division
State Corporation Commission
212 North Market, Insurance Bldg.
Wichita, Kansas

WELL PLUGGING RECORD

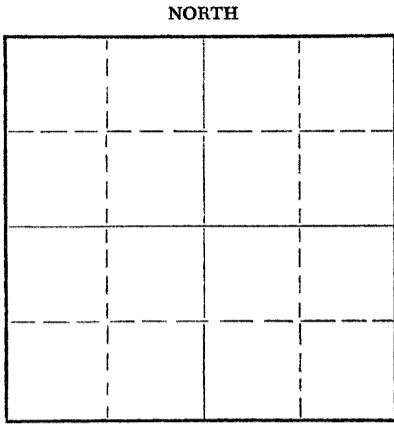

Locate well correctly on above Section Plat

Decatur County, Sec. 23 Twp. 1 Rge. 27 (X) (W)
Location as "NE/CNW/SW" or footage from lines C NW NE
Lease Owner Savage Drilling Co., Inc.
Lease Name McQuillan Well No. 1
Office Address Oberlin, Kansas.
Character of Well (completed as Oil, Gas or Dry Hole) Dry
Date well completed February 25, 19 62
Application for plugging filed February 25, 19 62
Application for plugging approved February 25, 19 62
Plugging commenced February 26, 19 62
Plugging completed February 26, 19 62
Reason for abandonment of well or producing formation Dry

If a producing well is abandoned, date of last production _____ 19 ____
Was permission obtained from the Conservation Division or its agents before plugging was commenced? Yes

Name of Conservation Agent who supervised plugging of this well Eldon Petty
Producing formation _____ Depth to top _____ Bottom _____ Total Depth of Well 3575 Feet
Show depth and thickness of all water, oil and gas formations.

OIL, GAS OR WATER RECORDS

CASING RECORD

FORMATION	CONTENT	FROM	TO	SIZE	PUT IN	PULLED OUT
<u>Lime & Sand</u>				<u>8 5/8"</u>	<u>110'</u>	<u>None</u>

Describe in detail the manner in which the well was plugged, indicating where the mud fluid was placed and the method or methods used in introducing it into the hole. If cement or other plugs were used, state the character of same and depth placed, from _____ feet to _____ feet for each plug set.

Filled with Heavy Mud and 1sax hulls to 540 ft; set plug with 20 sax cement
Filled with haevy mud and sax hulls to 175 ft. set plug with 20 sax cement
which surface casing open approximalty 110 ft for fresh water well for the
land owners use which he authorized.

RECEIVED
STATE CORPORATION COMMISSION

MAR 22 1962

CONSERVATION DIVISION
Wichita, Kansas

(If additional description is necessary, use BACK of this sheet)
Name of Plugging Contractor Savage Drilling Co., Inc. 3-22-1962
Address Oberlin, Kansas.

STATE OF Kansas, COUNTY OF Decatur, ss.

(employee of owner) or (owner or operator) of the above-described well, being first duly sworn on oath, says: That I have knowledge of the facts, statements, and matters herein contained and the log of the above-described well as filed and that the same are true and correct. So help me God.

(Signature) Emory Johnson Employee

SUBSCRIBED AND SWORN TO before me this 11 day of March, 1962

My commission expires June 18, 1962
Jamie Bryan
Notary Public.



