


STATE OF KANSAS
STATE CORPORATION COMMISSION

Give All Information Completely
Make Required Affidavit
Mail or Deliver Report to:
Conservation Division
State Corporation Commission
211 No. Broadway
Wichita, Kansas

15-039-00180-00-00
WELL PLUGGING RECORD

NORTH

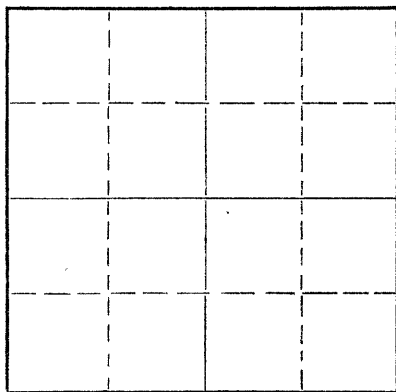

Locate well correctly on above
Section Plat

Decatur County. Sec. 15 Twp. 1S Rge. 27 (E) W (W)

Location as "NE/CNW/SW" or footage from lines SE SE NE

Lease Owner Great Basins Petroleum Co.

Lease Name Huff Well No. 1

Office Address 1515 Mile High Center, Denver 2, Colorado

Character of Well (completed as Oil, Gas or Dry Hole) Dry Hole

Date well completed June 12, 1957

Application for plugging filed June 12, 1957

Application for plugging approved June 12, 1957

Plugging commenced June 12, 1957

Plugging completed June 12, 1957

Reason for abandonment of well or producing formation Dry Hole

If a producing well is abandoned, date of last production 19

Was permission obtained from the Conservation Division or its agents before plugging was commenced? yes

Name of Conservation Agent who supervised plugging of this well Eldon Petty

Producing formation Depth to top Bottom Total Depth of Well 3575 Feet

Show depth and thickness of all water, oil and gas formations.

OIL, GAS OR WATER RECORDS

CASING RECORD

FORMATION	CONTENT	FROM	TO	SIZE	PUT IN	PULLED OUT
		0	305'	8 5/8"	305'	none

Describe in detail the manner in which the well was plugged, indicating where the mud fluid was placed and the method or methods used in introducing it into the hole. If cement or other plugs were used, state the character of same and depth placed, from feet to feet for each plug set.

From 3575' to 300' - heavy rotary mud and plug
300' to 238' - 1/2 sack hulls and 20 sacks cement
238' to 40' - heavy rotary mud and plug
40' to 6' - 1/2 sack hulls and 10 sacks cement
6' to surface - cellar

(If additional description is necessary, use BACK of this sheet)

Name of Plugging Contractor Peel Brothers, Inc.
Address P.O. Box 88, Hoisington, Kansas

STATE OF KANSAS, COUNTY OF BARTON, ss.
Peel Brothers, Inc. (employee of owner) or (owner or operator) of the above-described

well, being first duly sworn on oath, says: That I have knowledge of the facts, statements, and matters herein contained and the log of the above-described well as filed and that the same are true and correct. So help me God. PEEL BROTHERS, INC.

(Signature) BY: Al H. Smith

P.O. Box 88, Hoisington, Kansas (Address)

SUBSCRIBED AND SWORN TO before me this 13th day of June, 1957

My commission expires April 27, 1960

Ruth Brank Notary Public.
RECEIVED
STATE CORPORATION COMMISSION

PLUGGING
FILE SEC 15 T. 1 27W
BOOK PAGE 20 LINE 26

JUN 23 1957
6-20-1957
CONSERVATION DIVISION

15-039-00180-00-00

DRILLERS' LOG

Company: Great Basins Petroleum Company

SE SE NE
Sec. 15, Twp. 1S, Rge. 27W,

Farm Name: Huff Well No. 1

County: Decatur,
Kansas

Total Depth: 3575'

Comm: 6/4/57 Comp: 6/12/57

Contractor: Peel Brothers, Inc.

Elevation:

Casing: 8 5/8" @ 305' cem.

Production: Dry

Figures below indicate bottoms of formations:

Sand and shale	0 -	305
Shale		925
Sand		1105
Shale, sand streaks		1260
Sand		1450
Red bed and shale		1690
Red bed		1865
Anhydrite		1895
Red bed and shale		2360
Lime and shale		2968
Lime, sand and shale		3070
Lime and shale		3170
Lime		3370
Lime and shale		3456
Lime and sand		3504
Sand and shale		3525
Shale and granite wash		3567
Granite		3575
Total Depth		3575

This is to certify that the above information is to the best of our knowledge, true and correct.

PEEL BROTHERS, INC.

BY: Al H. Smith

SUBSCRIBED AND SWORN to before me this 13th day of June, 1957

My commission expires: April 27, 1960

Ruth Brack
Notary Public

RECEIVED
STATE CORP
6-20-1957

CONF. DIVISION

PLUGGING
FILE SEC. 15 T. 1 R. 27W
BOOK PAGE 20 LINE 26