


WELL PLUGGING RECORD

Give All Information Completely
Make Required Affidavit
Mail or Deliver Report to:
Conservation Division
State Corporation Commission
211 No. Broadway
Wichita, Kansas

NORTH

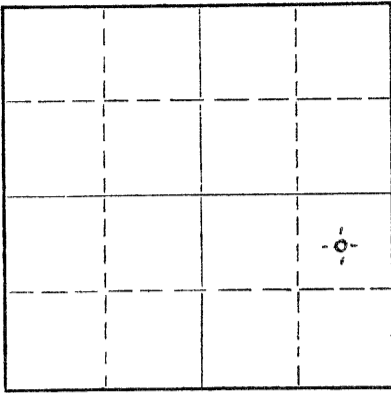

Locate well correctly on above
Section Plat

Decatur County. Sec. 8 Twp. 1S Rge. (E) 27(W)
Location as "NE/CNW/SW" or footage from lines NE SE
Lease Owner Pubco Petroleum Corporation
Lease Name Ackman-Green Well No. 1-8I
Office Address Box 432, McCook, Nebraska
Character of Well (completed as Oil, Gas or Dry Hole) Dry Hole
Date well completed October 13 1963
Application for plugging filed October 21 1963
Application for plugging approved October 23 1963
Plugging commenced October 21 1963
Plugging completed October 23 1963
Reason for abandonment of well or producing formation non-productive

If a producing well is abandoned, date of last production 19
Was permission obtained from the Conservation Division or its agents before plugging was commenced? Yes

Name of Conservation Agent who supervised plugging of this well Bill Nichols
Producing formation Depth to top Bottom Total Depth of Well 3680 Feet
Show depth and thickness of all water, oil and gas formations.

OIL, GAS OR WATER RECORDS

CASING RECORD

FORMATION	CONTENT	FROM	TO	SIZE	PUT IN	PULLED OUT
Lansing K.G.	salt water	3299	3506	8 5/8" 24#	278'	none
				2 7/8" 6.5#	3570'	2710'

Describe in detail the manner in which the well was plugged, indicating where the mud fluid was placed and the method or methods used in introducing it into the hole. If cement or other plugs were used, state the character of same and depth placed, from feet to feet for each plug set.

Baker C.I. bridge plug at 3370'
Plugged back to 3271' (above perforations) with gravel & sand
Dumped 1 sack cement from 3271 to 3255'
Shot off 2 7/8" casing at 2710'. Circulated hole with mud.
Pulled 2 7/8" to 620'. Filled hole with mud
Spotted 20 sacks through 2 7/8" from 620-560'
Pulled 2 7/8" to 280'
Spotted 20 sacks through 2 7/8" from 280-220'
Pulled tubing
Placed 10 sack plug at 30'
Finished plugging at 6:00 PM 10-23-63

RECEIVED
STATE CORPORATION COMMISSION
11-12-1963
NOV 12 1963

CONSERVATION DIVISION
Wichita, Kansas

(If additional description is necessary, use BACK of this sheet)

Name of Plugging Contractor Coleman Bros. Well Service
Address Box 543, McCook, Nebraska

STATE OF Nebraska, COUNTY OF Red Willow, ss.
I, Michael E. Carr (employee of owner) or (owner or operator) of the above-described well, being first duly sworn on oath, says: That I have knowledge of the facts, statements, and matters herein contained and the log of the above-described well as filed and that the same are true and correct. So help me God.

(Signature) Michael E. Carr
Michael E. Carr
Box 432, McCook, Nebraska
(Address)

SUBSCRIBED AND SWORN TO before me this 8th day of November, 1963

My commission expires April 9, 1969

Samuel F. Poppler
Notary Public.



15-039-19015-00-00

KANSAS GEOLOGICAL SOCIETY
KANSAS WELL LOG BUREAU - KANSAS WELL SAMPLE BUREAU
KANSAS GEOLOGICAL SOCIETY BUILDING
508 EAST MURDOCK - WICHITA, KANSAS

COMPANY PUBCO PETROLEUM CORP.


SEC. 8 T. 1 R. 27W
LOC. C SE NE

FARM Ackman-Green NO. 1

COUNTY Decatur

TOTAL DEPTH 3860'
COMM. 10-5-62

COMP. 1-24-63

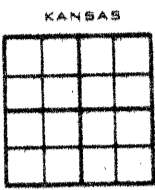

SHOT OR TREATED
CONTRACTOR Murfin Drlg/ Co.
ISSUED 1-11-64

CASING

20 10
15 8 5/8 278' w/215 sx cem.
12 6
13 8 2 7/8 3570' w/160 sx cem.

ELEVATION 2606'

PRODUCTION DRY

FIGURES INDICATE BOTTOM OF FORMATIONS

surface soil sand 230
shale 277
shale 340
shale, sand 1245
Gyp, shale 1601
red bed 200t
anhydrite 2029
shale 2175
shale, sand 2486
shale, lime 2860
lime shale 3395
lime 3455
lime shald 3542
lime sand, granite
wash 3680 RTD
Total Depth

TOPS: SCOUT
Topeka 3095
Deer Creek 3150
Oread 3241
Lansing 3299
B/Kansas City 3511
Reagan sand 3653
Weathered Granite 3657
Pre Cambrian 3764

RECEIVED
STATE CORPORATION COMMISSION
2-21-1964
FEB 21 1964
CONSERVATION DIVISION
Wichita, Kansas