


Give All Information Completely  
Make Required Affidavit  
Mail or Deliver Report to:  
Conservation Division  
State Corporation Commission  
212 No. Market  
Wichita, Kansas

WELL PLUGGING RECORD

15-039-19016-00-01

Decatur County, Sec. 11 Twp. 1S Rge. (E) 27 (W)

Location as "NE/CNW%SW%" or footage from lines 990' FSL & 2310' FWL  
Lease Owner Cities Service Oil Company  
Lease Name Warner Unit Well No. 404S  
Office Address Box 553 Russell, Kansas 67665  
Character of Well (completed as Oil, Gas or Dry Hole) Water Supply Well  
Date well completed 3-19 1966  
Application for plugging filed 4-20 1967  
Application for plugging approved 4-21 1967  
Plugging commenced 5-18 1967  
Plugging completed 5-18 1967  
Reason for abandonment of well or producing formation Inadequate Water Supply

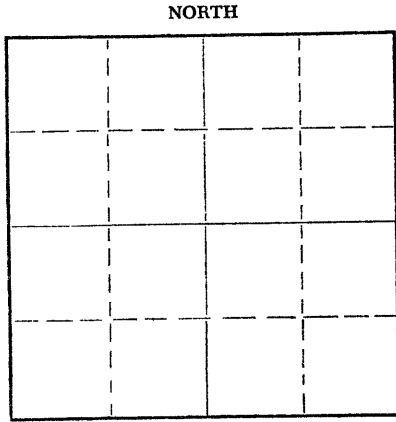

Locate well correctly on above Section Plat

If a producing well is abandoned, date of last production - 19  
Was permission obtained from the Conservation Division or its agents before plugging was commenced? Yes

Name of Conservation Agent who supervised plugging of this well Mr. W. L. Nichols  
Producing formation 500' Shale & Sand Depth to top 0 Bottom 1050 Total Depth of Well 500 Feet  
Show depth and thickness of all water, oil and gas formations.

OIL, GAS OR WATER RECORDS

CASING RECORD

FORMATION	CONTENT	FROM	TO	SIZE	PUT IN	PULLED OUT
				8 5/8"	320	None

Describe in detail the manner in which the well was plugged, indicating where the mud fluid was placed and the method or methods used in introducing it into the hole. If cement or other plugs were used, state the character of same and depth placed, from \_\_\_\_\_ feet to \_\_\_\_\_ feet for each plug set.

Well originally drilled to a total depth of 1650' August 12, 1957, lost hole and P & A August 16, 1957.  
Attempt was made 3-19-66 to drill cement and plugs and complete as a water supply well. Water supply was inadequate at 500' and well was plugged to state specifications at 12 Noon 5-18-67 as follows:  
Mixed and pumped in 180 sx. cement (16.1#/gal.)  
Hole full - shut in at 100# pressure  
Cut off 8 5/8" casing 4' below surface. Welded on cap  
Filled cellar to surface

RECEIVED  
STATE CORPORATION COMMISSION  
FEB 23 1968  
CONSERVATION DIVISION  
Wichita, Kansas

(If additional description is necessary, use BACK of this sheet)

Name of Plugging Contractor Halliburton Company  
Address Hays, Kansas

STATE OF Kansas, COUNTY OF Russell, ss.  
M. M. Hardin (employee of owner) or ~~owner~~ of the above-described well, being first duly sworn on oath, says: That I have knowledge of the facts, statements, and matters herein contained and the log of the above-described well as filed and that the same are true and correct. So help me God.

(Signature) M. M. Hardin M. M. Hardin, Dist. Supt.  
Box 553 Russell, Kansas 67665  
(Address)

SUBSCRIBED AND SWORN TO before me this 22nd day of February, 19 68

My commission expires 10-5-68

James F. Kyger  
James F. Kyger Notary Public.